

Hayes to Winder Survey

April, 1977

Being situated in M<sup>c</sup>Arthur Township, Logan County, Ohio; and being a part of V.M.S. 9904.

TRACT I :

Beginning at a stone in the center of State Route 274 that is shown as Station 19 + 80 in the County Engineer's Field Book 598, page 34. Said stone is also the northwest corner of Hayes 10.68 acre tract.

Thence with the center of State Route 274 N 84°-18' E 394.4 feet to an iron. Said iron is the true place of beginning for this description.

Thence S 0°-38' W 193.7 feet to an iron, passing thru an iron at 40.0 feet.

Thence S 89°-22' E 218.3 feet to an iron.

Thence N 0°-38' E 5.0 feet to a point in the south line of Lot 34 of the Village of Cherokee.

Thence with the south line of Lots 34, 35, and 36 of the Village of Cherokee N 89°-22' W 162.2 feet to a point.

Thence with the west line of the Village of Cherokee N 0°-38' E 200.0 feet to an iron in the center of State Route 274.

Thence with the center of State Route 274 S 84°-18' W 56.6 feet to the place of beginning.

Containing 0.26 of an acre more or less. Being surveyed from a 10.68 acre tract.

TRACT II :

Being the west 35.7 feet of Lot 34, and all of Lot 35 and Lot 36 of the Village of Cherokee.

It is the intention of this survey to give 1.00 acre of land to meet the zoning requirements of M<sup>c</sup>Arthur Township, and Logan County.

---


Owen K. Shirk  
Surveyor 4271

ID

6025

INDEXED ON MAP

HAYES TO WINDER SURVEY  
 McARTHUR TWP., LOGAN CO., OHIO  
 V.M.S. 9904 - 1" = 50'

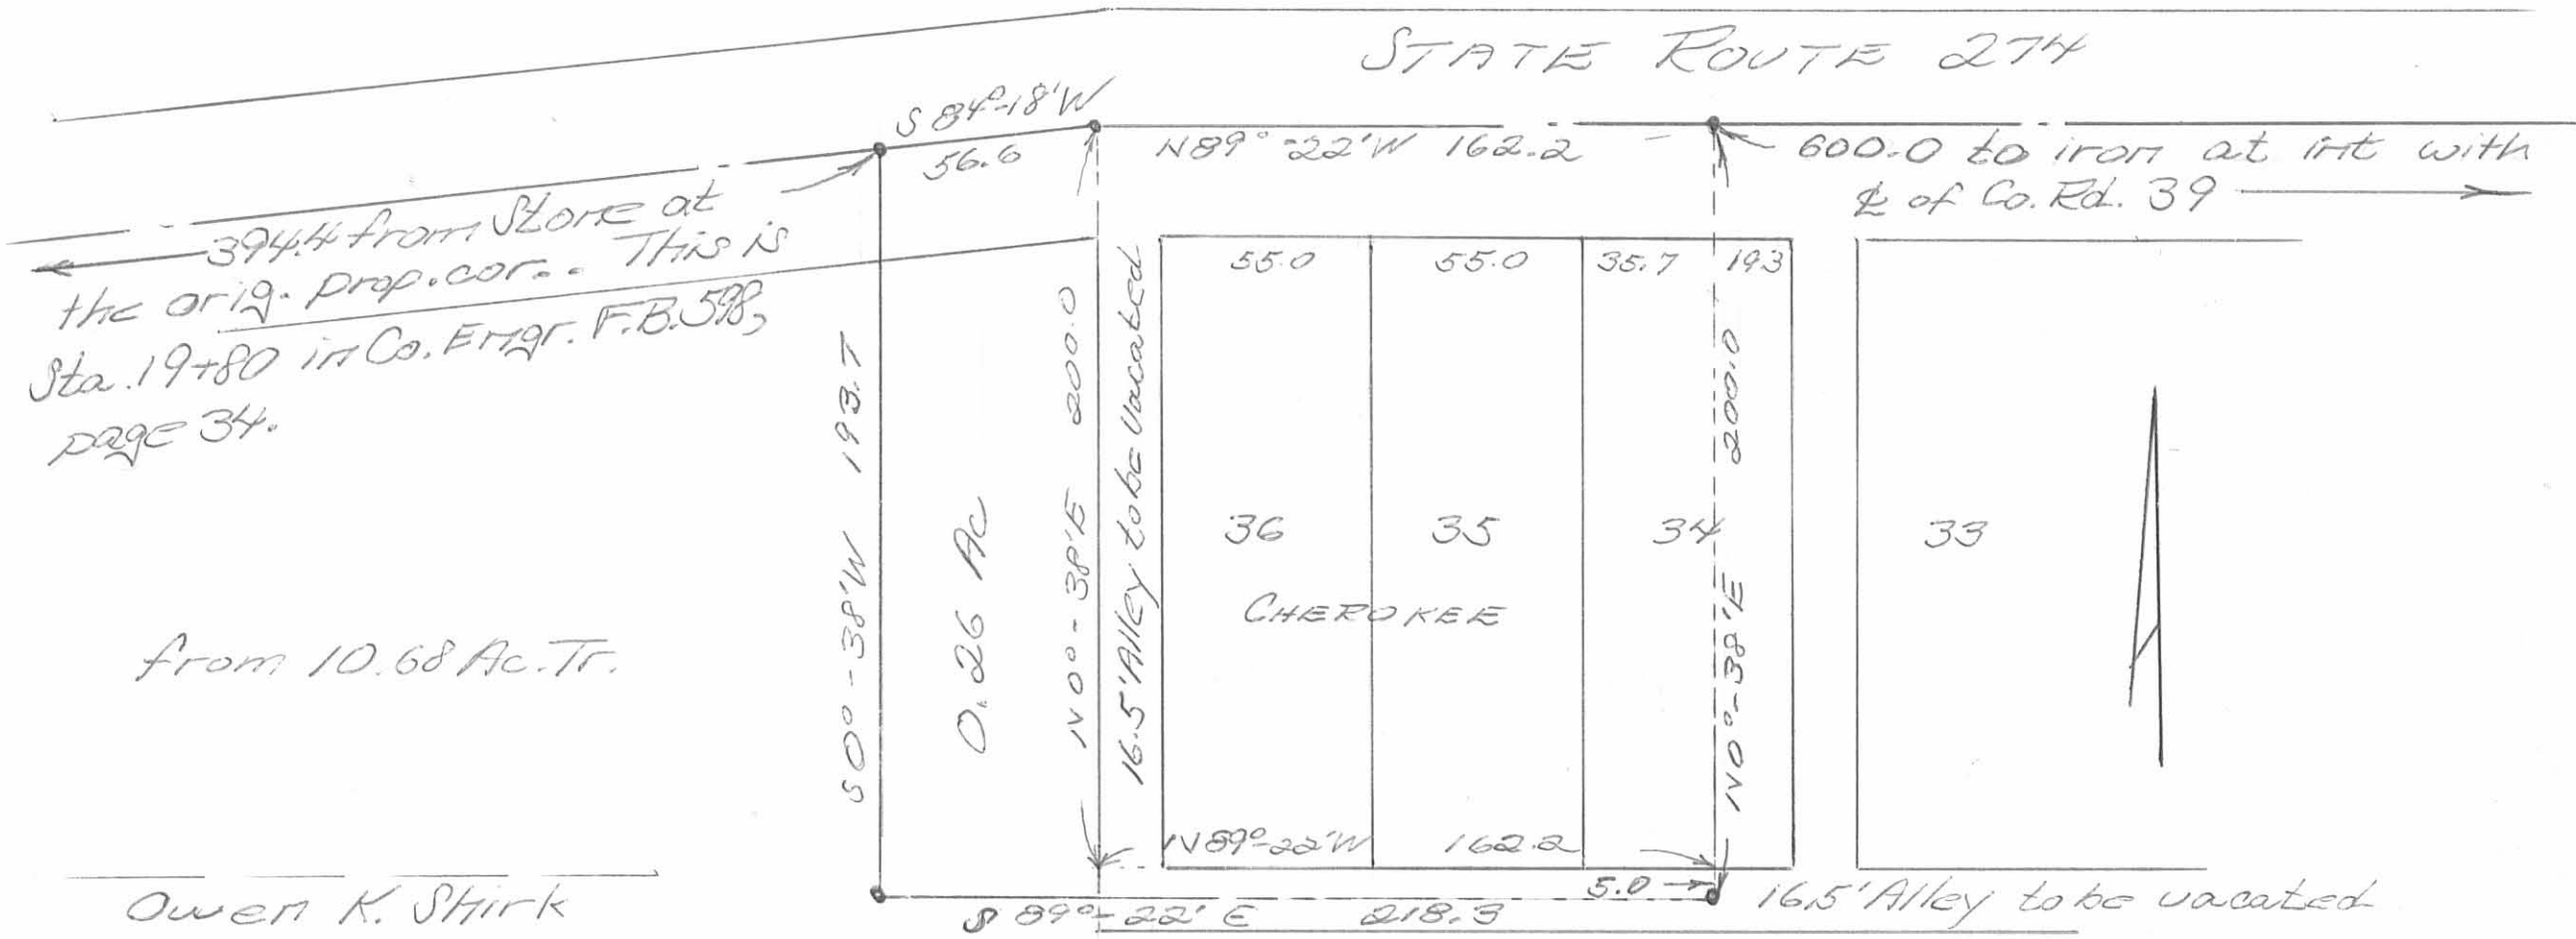

from 10.68 Ac. Tr.

Owen K. Shirk  
 Surveyor 4271  
 April 26, 1977

NOTE: It is the intention of this survey to give 1.00 acre of land to meet zoning requirements.

NO HISTORY

6025  
 11