BELL DESCRIPTION V.M.S. 10306 MCARTHUR TOWNSHIP August 12, 1972

The following described real estate situated in McArthur Township, Logan County, Ohio and being part of Virginia Military Survey 10306 and more particularly described as follows:

Commencing at an iron pin in the west line of said V.M.S. 10306 at the southwest corner of Richard Fullerton's 2.03 acre tract; thence with said Fullerton's south line N. 81°00' E. 259.62 feet to an iron bar, passing said Fullerton's southeast corner at 209.5 feet; thence N. 5°00' W. 350.85 feet to an iron bar; thence N. 81°00' E. 253.21 feet to an iron bar; thence N. 5°07' W. 898.50 feet to an iron bar, said iron bar being the beginning point of this description; thence continuing N. 5°07' W. 150.00 feet to an iron bar; thence S. 84°16' W. 200.00 feet to an iron bar; thence S. 5°07' E. 230.00 feet; thence N. 84°16' E. 50.00; thence N. 5°07' W. 80.00 feet; thence N. 84°16' E. 150.00 feet to the place of beginning.

Containing 0.78 of an acre more or less.



STREET OF TERP

BELL SURVEY
V.M.S. 10306
MCARTHUR TOWNSHIP
July 1, 1975

BELL to MORAN

The following described real estate situated in McArthur Township, Logan County, Ohio and being part of Virginia Military Survey 10306 and more particularly described as follows:


Commencing at an iron bar at the intersection of the north line of Wyandot Drive and the west line of Shawnee Drive, said iron bar also being the southeast corner of Russell E. Berry's 0.53 acre tract as described in Logan County deed record volume 353, page 715; thence with the west line of Shawnee Drive N.5° 07'W.

818.7 feet to an iron pipe, said pipe being the beginning point of this description; thence s.84° 16'W. 150.0 feet to an iron pipe at the southeast corner of John G. Moran's 0.78 acre tract; thence with said tract N.5° 07'W. 80.0 feet to a corner; thence with said Moran's tract N.84° 16'E. 150.00 feet to an iron bar in the west line of Shawnee Drive; thence with said west line s.5° 07'E.

Containing 0.28 of an acre more or less.



50' STREET

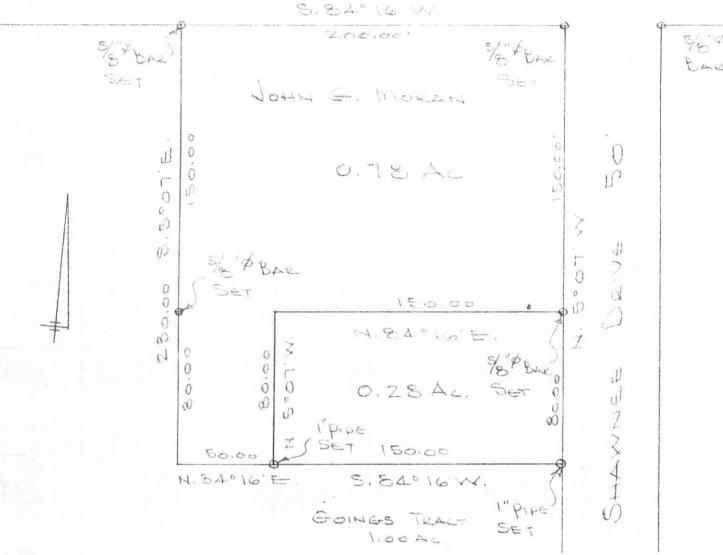

DELL SURVEY

V.M.S. 10306

MCARTHUR TOWNSHIR

LOCAU COUNTY OHIO

PUCUST 5, 1972

SCALE 1'- 50'

REVISED 7/1/75

DAN L. DODSON REG SURVEYER AZTO BELLEFONTAINE, O.

73/5 PUNDEXED ON MAP