


Road #69
Miami.

	may 14, 30	may 15-30	may 16, 30
A.M. Rensch	1	1	
Harold Taylor	1	1	
Mel Easton	x	1	
Chas. Daniel	x	1	
J.S. Crane			1
J.A. McKirahan			1
W.R. Stephen			1
Lyle Marine			1
Timber	paid 1.50	2.50	2.00

(1311)

INDEXED ON MAP

36

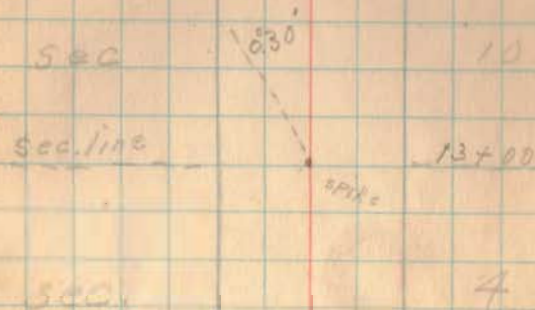

O.A. Weeks
7190
T.F. Barber

Geo T. Pool 5+02 20' stake
A. Keiter



Road #69

37

Highest Point
Large Boulder (X)
29.8
30.3
66+5.5
Road #72
Stake
Stake
Stake
597.45 = 10' C.P. 110 121

J.W. Wilkinson
29 30 52+72
Spike large Post
O.P. Woods

40184 = 15' C.P. 77 101

Chas. Reeseter
0.10
Anders Post
39+53
18' center
Cemetery
123.6
30.3
Def 10' R.
Road #60

Cemetery 36+87
Geo T Pool

2.5 6 17+63 = 3x3
Cox Cox

1311
INDEXED ON MAP