

U. M. Stiles

N. W.

Part of Quincy
Sec. 30 T. 3 R. 13

36

Start on Sec. Line (stone)
in W. line Quincy Corp.

Random N 3 1/2 E
(producing wire fence line N.)

at 15.84 (1012') set
stake in random line,
being near NW \angle of Corp.

Could not find old \angle stake

- Random S 86 1/2 E

at 12.20 E. line Rte. 100 way

at 30.59 old fence in Sec line

at 36.00 ~~in~~ about 25' N. of

old Sign. stump at outlet

Sweet Root Creek at S. bank

Miami

Start at random stake on Sec
Line -

- with Sec line

at 14.15 fence to W

- S. line - S 89 1/4 W

at 14.10 Cent R.R.

18.57 NE \angle 196 track

28.18 NE \angle 500 at Roseway

30.36 Stone at beginning


1509

INDEXED ON MAP

19a track
 Commence at NE \swarrow - (beginning
 1857 of S. line previous page)
 S. $3\frac{1}{2}$ W
 or 18.31 Cent. pike
 18.72 N. fence R.R.
 19.11 Cent. Proj. 4

with Cent. R.R. S85W
 or 9.16 S \swarrow 5a (Barrow)
 12.23 W. Corp. line.

W. Corp. line N $3\frac{1}{2}$ E
 21.35 to begin

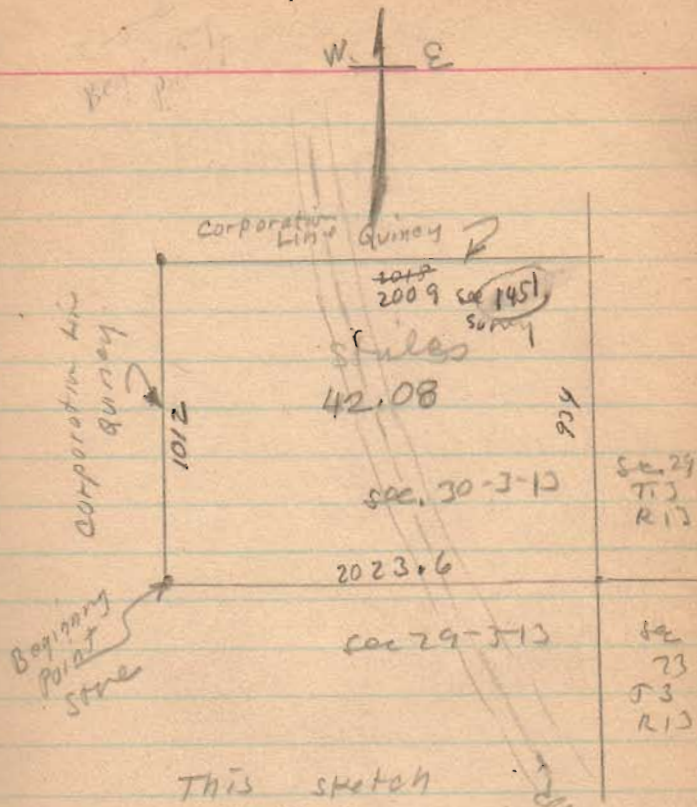

This sketch
 Made By
 Wm H. Oct 1933.
 To show location.

1509

INDEXED ON MAP