


STEVENSON SURVEY
 SEC. 35 T-4 R-13
 MIAMI TOWNSHIP
 LOGAN COUNTY, OHIO
 OCTOBER 14, 1978
 SCALE 1" = 50'

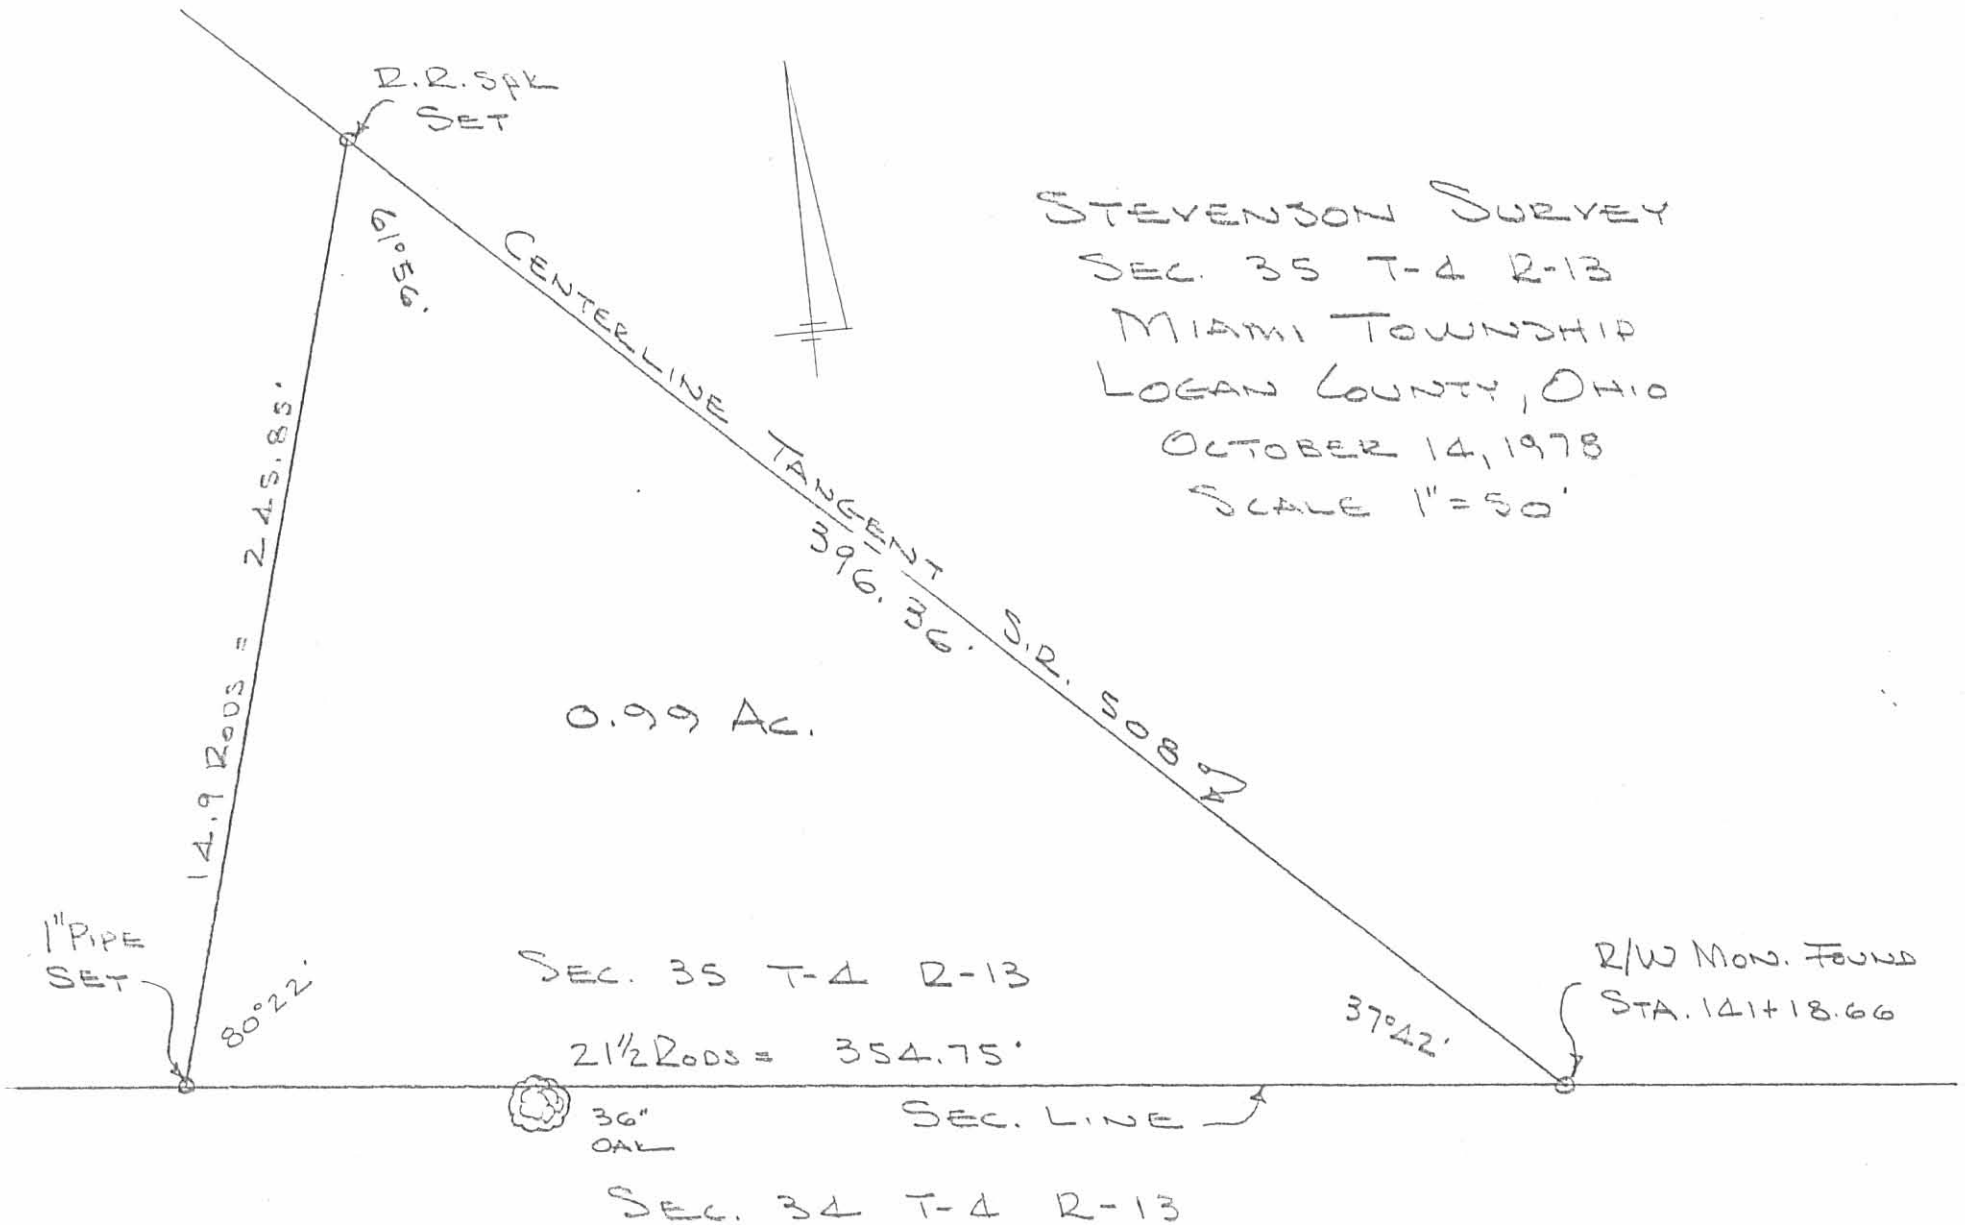

REF:
 DEED VOL. 329 PG. 559

INDEXED ON MAP
 1978 IP

DAN L. DODSON
 REG. SURVEYOR 4270
 BELLEFONTAINE, O.