


FB 699

C. H. # 62 & 69
 Sec. 32 T-2 R-13
 Miami Twp.

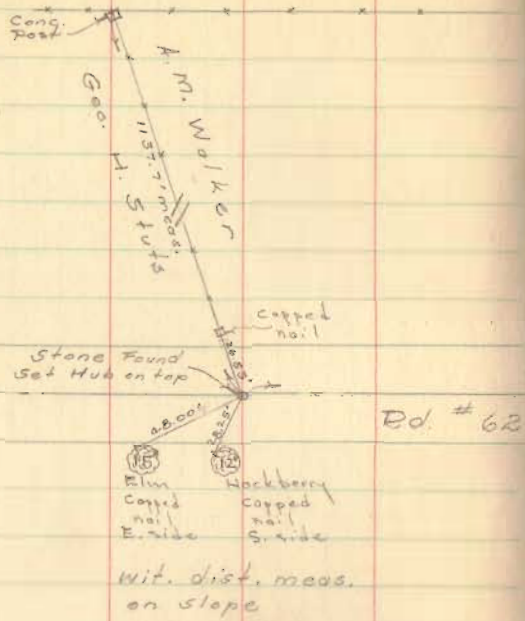


Rd. # 62 - 40' wide
 Rd. # 69 - 40' wide

D. Dodson
 T. Richardson
 P. Sweeney *
 C. Gebby

July 1-2, 1952
 80°

23

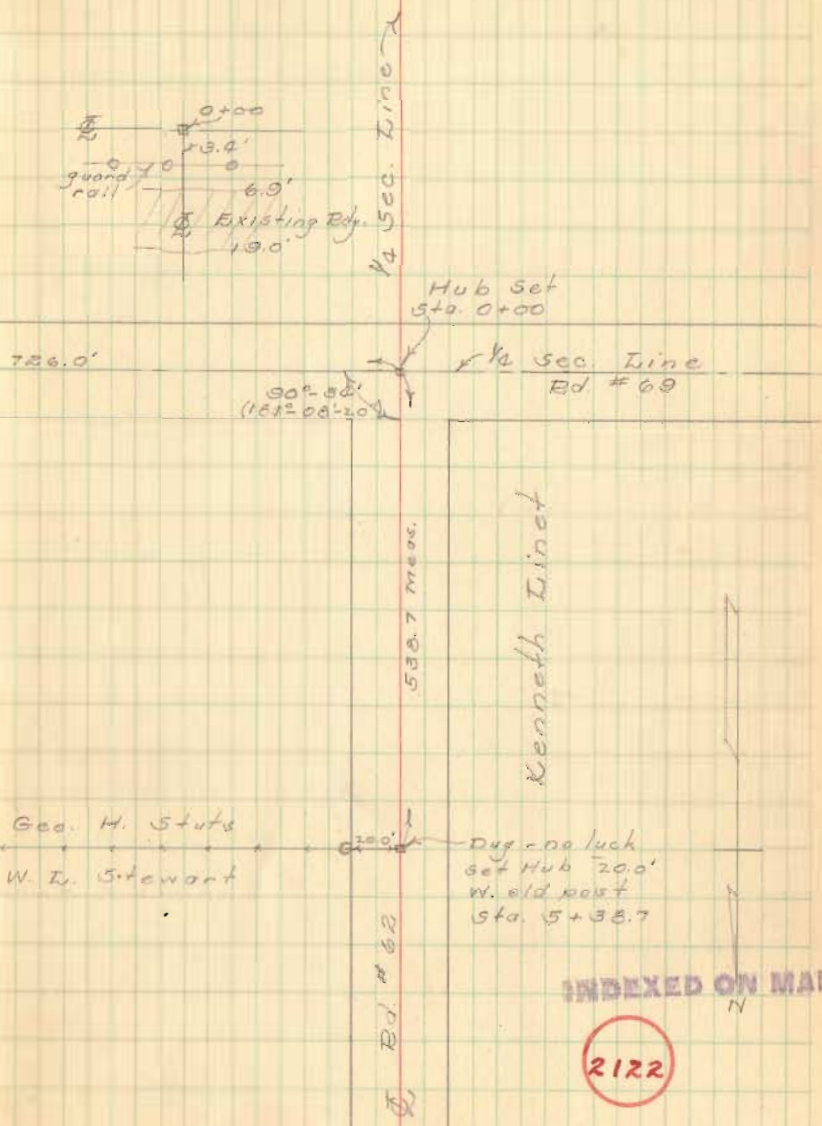

INDEXED ON MAP

2122

INDEXED ON MAP