


Flack EQUIPMENT COMPANY


1240 McCOOK AVENUE
DAYTON 1, OHIO
Phone - 226-3561

10660 EVENDALE DR.
CINCINNATI 41, OHIO
Phone - Princeton 1-0350

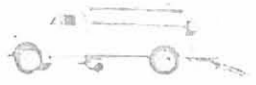

LITTLEFORD DISTRIBUTORS
TAR & ASPHALT PAVEMENT

MARCH 5, 1985
COLL. BLUSTERN
D. GILBERT
C. NICHOLS
K. C. GILL

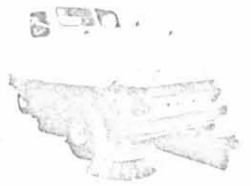

WAYNE SWEEPERS



W.K. SALT & CINDER
SPREADERS



MALSBARY
STEAM CLEANERS




CENCUS
CONCRETE SAWS

Kelly-Creswell
Line Strippers

Air Placement Equip. Co.
Grimco Signs

W. H. Stewart Sewer Cleaner

Quincy Stationary
Compressors

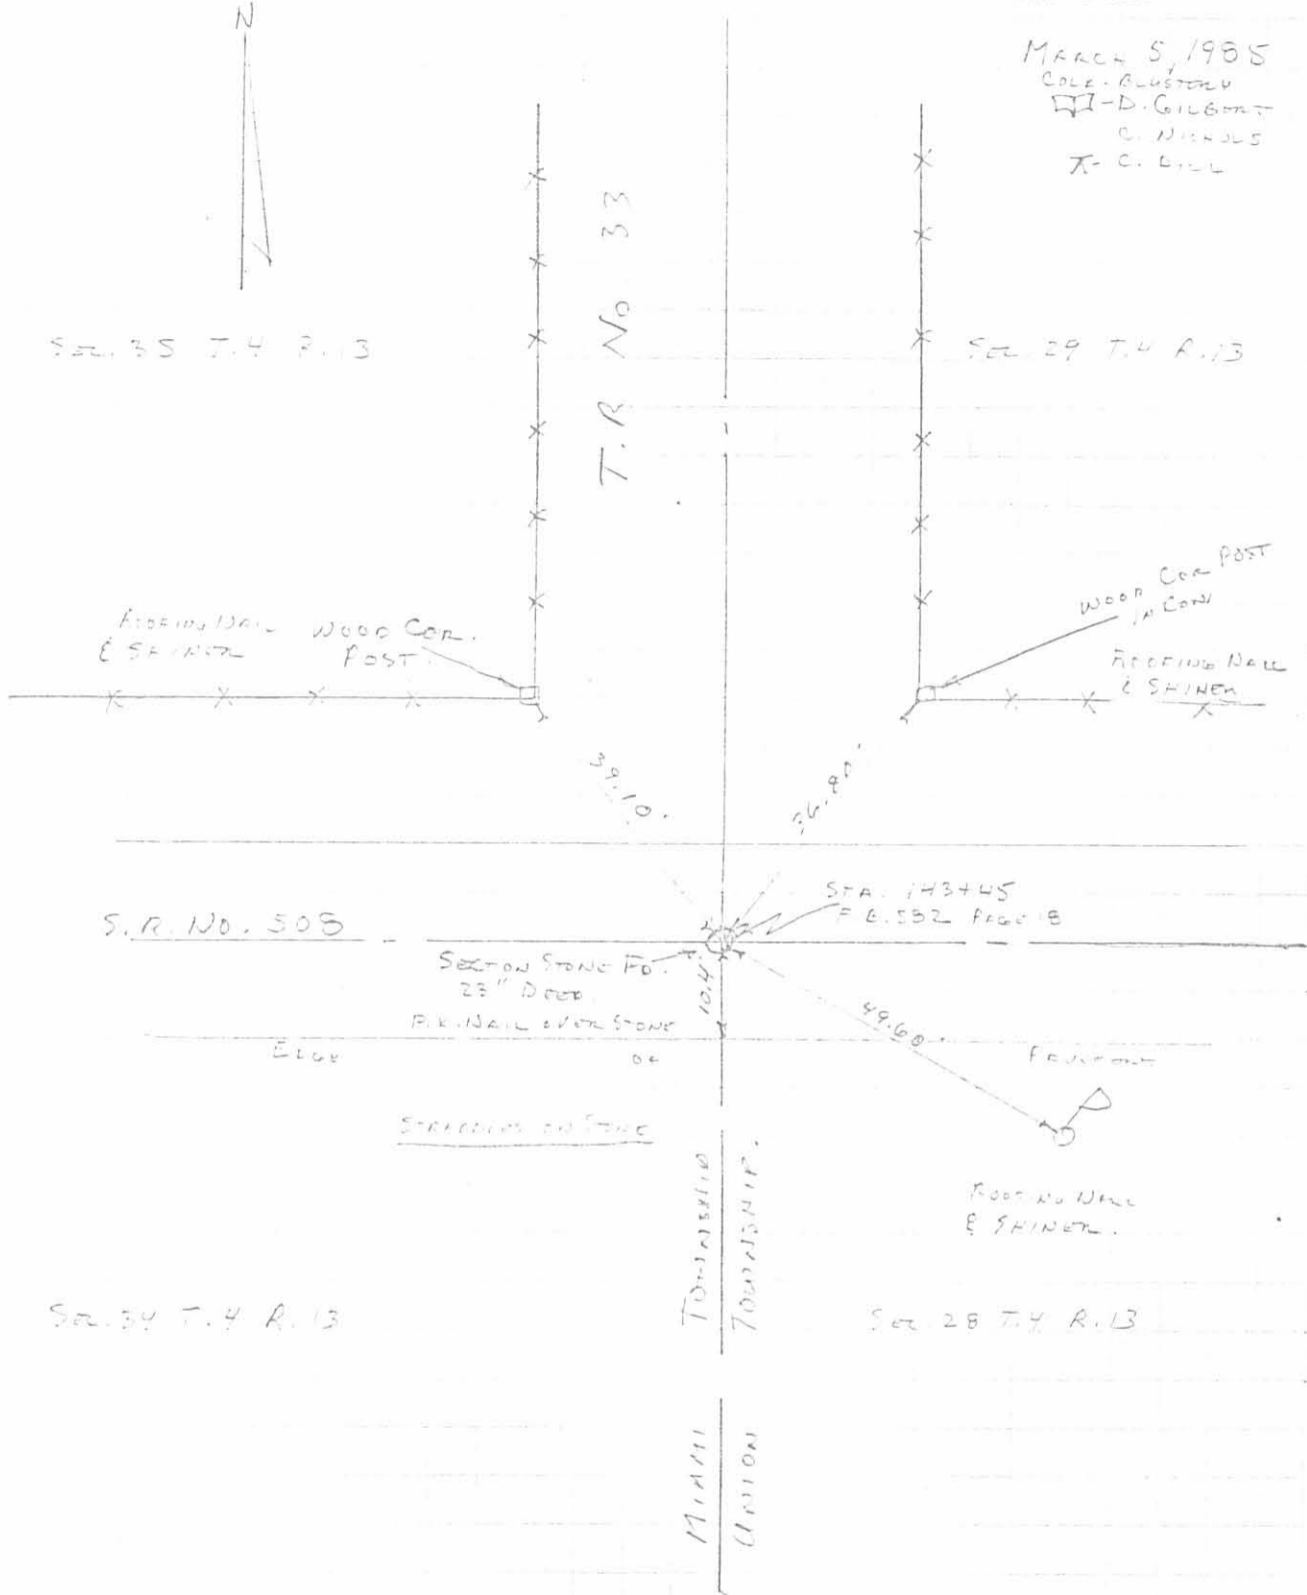

Complete Line of Rental Equipment Also Available

INDEXED ON MAP
7344 1P

Received 4-16-85

Town 4 Range 13

COLD-CLEAR MARCH 6, 1985
25° F.

①
H - D. GILBERT
K - C. NICHOLS
T - C. BILL

T-16



T.R. No. 30

RESURVEY MON.

TOWNSHIP

TOWNSHIP

Iron bar

T.R. No. 33

SEC. 35

SEC. 29

S.R. No. 508

3181.33'

5.84° 57' E.
F.B. 582 P. 17

S.R. No. 508

30'
R/W Mon. Fa.
STA. 155+00
F.B. 582 P. 19

Cons. R/W.
Mon.

P.I. Sta. 111+61
F.B. 582 P. 17

(111+63.67)

C.H. No. 62

① 10°-01.8'
270°-02.0'
179°-59.9'

① 90°-01.8'
270°-02.0'
179°-59.9'

90°-01.9'

SEC. 34

SEC. 28

004.8'
0°-05.4'
179°-59.9'

2700.9'

To SECTION
At corner line

5396.68'

1" IRON BAR Fa. (5" DEEP)
F.B. 700 P. 3
P.I. STA. 40+45.1

5396.68
2700.98
2695.70

T.R. No. 69

C.H. No. 62

INDEXED ON MAP
7344 2P

MIAMI

UNION

2695.70'

1" IRON BAR SHAFT Fa.
F.B. 700 P. 2
P.I. STA. 13+50.4

C.H. No. 62

LOGAN COUNTY
CHAMPAIGN COUNTY

79.8'

15.00'

HOUSE

BARN

570 D22
CHEV
Dodge 6/8