


N. 240 Mr Corner S.

8324

S. 22. 13. R. 13 (N.R.)

Mr Corner made

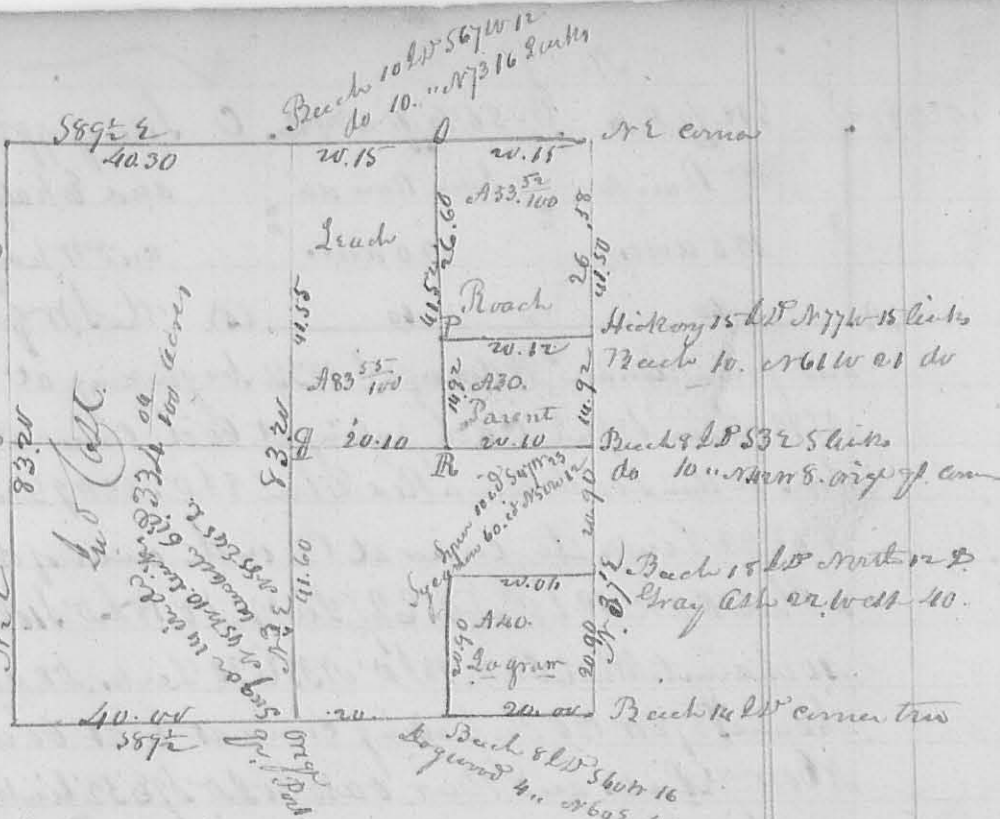


Corner at 'O' White ash 6 l. W 56 1/2 E 43 links
 .. at P Beach 12 l. W N 48 W 4 1/2 links Sugar 19 l. W 58 1/2 E 5 links -
 .. of Poplar 24 l. W N 66 3/4 E 33 links
 .. R Ash 6 l. W S 32 W 5 links Elm 18 l. W N 32 E 19 links

John Coplin }
 Mr Parent } ch. ma. Apr. 18. 1834 L Hopkins depy. Sur. G.

S. 15. 71. R. 8 E

N. 241

8325

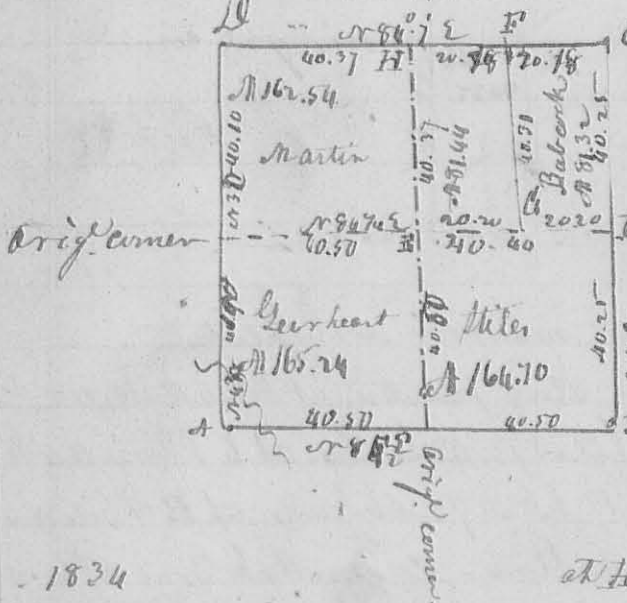

Description of corner not marked on the plat. at I Beach 18 l. W East 50 links Elm 18. 1/2. N 77 1/2 E
 at F' blue ash 4 l. W S 30 E 20 links -
 do. 18 l. W. 24 links -
 at Beach 16 l. W N 10 E 17 1/2 links
 Ironwood 6 l. W S 22 W 7 links
 H Hickory 18 l. W S 66 W 29 N. all 4 links N 23 1/2 E 9 links -
 at H' Gray ash 10. l. W N 70 W 13 1/2 links
 do 20 l. W. 56 3/4 E 33 1/2 links -

May 1834
 John J. Gearheart }
 Asahel Martin } ch. Cur.

L Hopkins depy. Sur. G.