



5-29-13

APPROVED

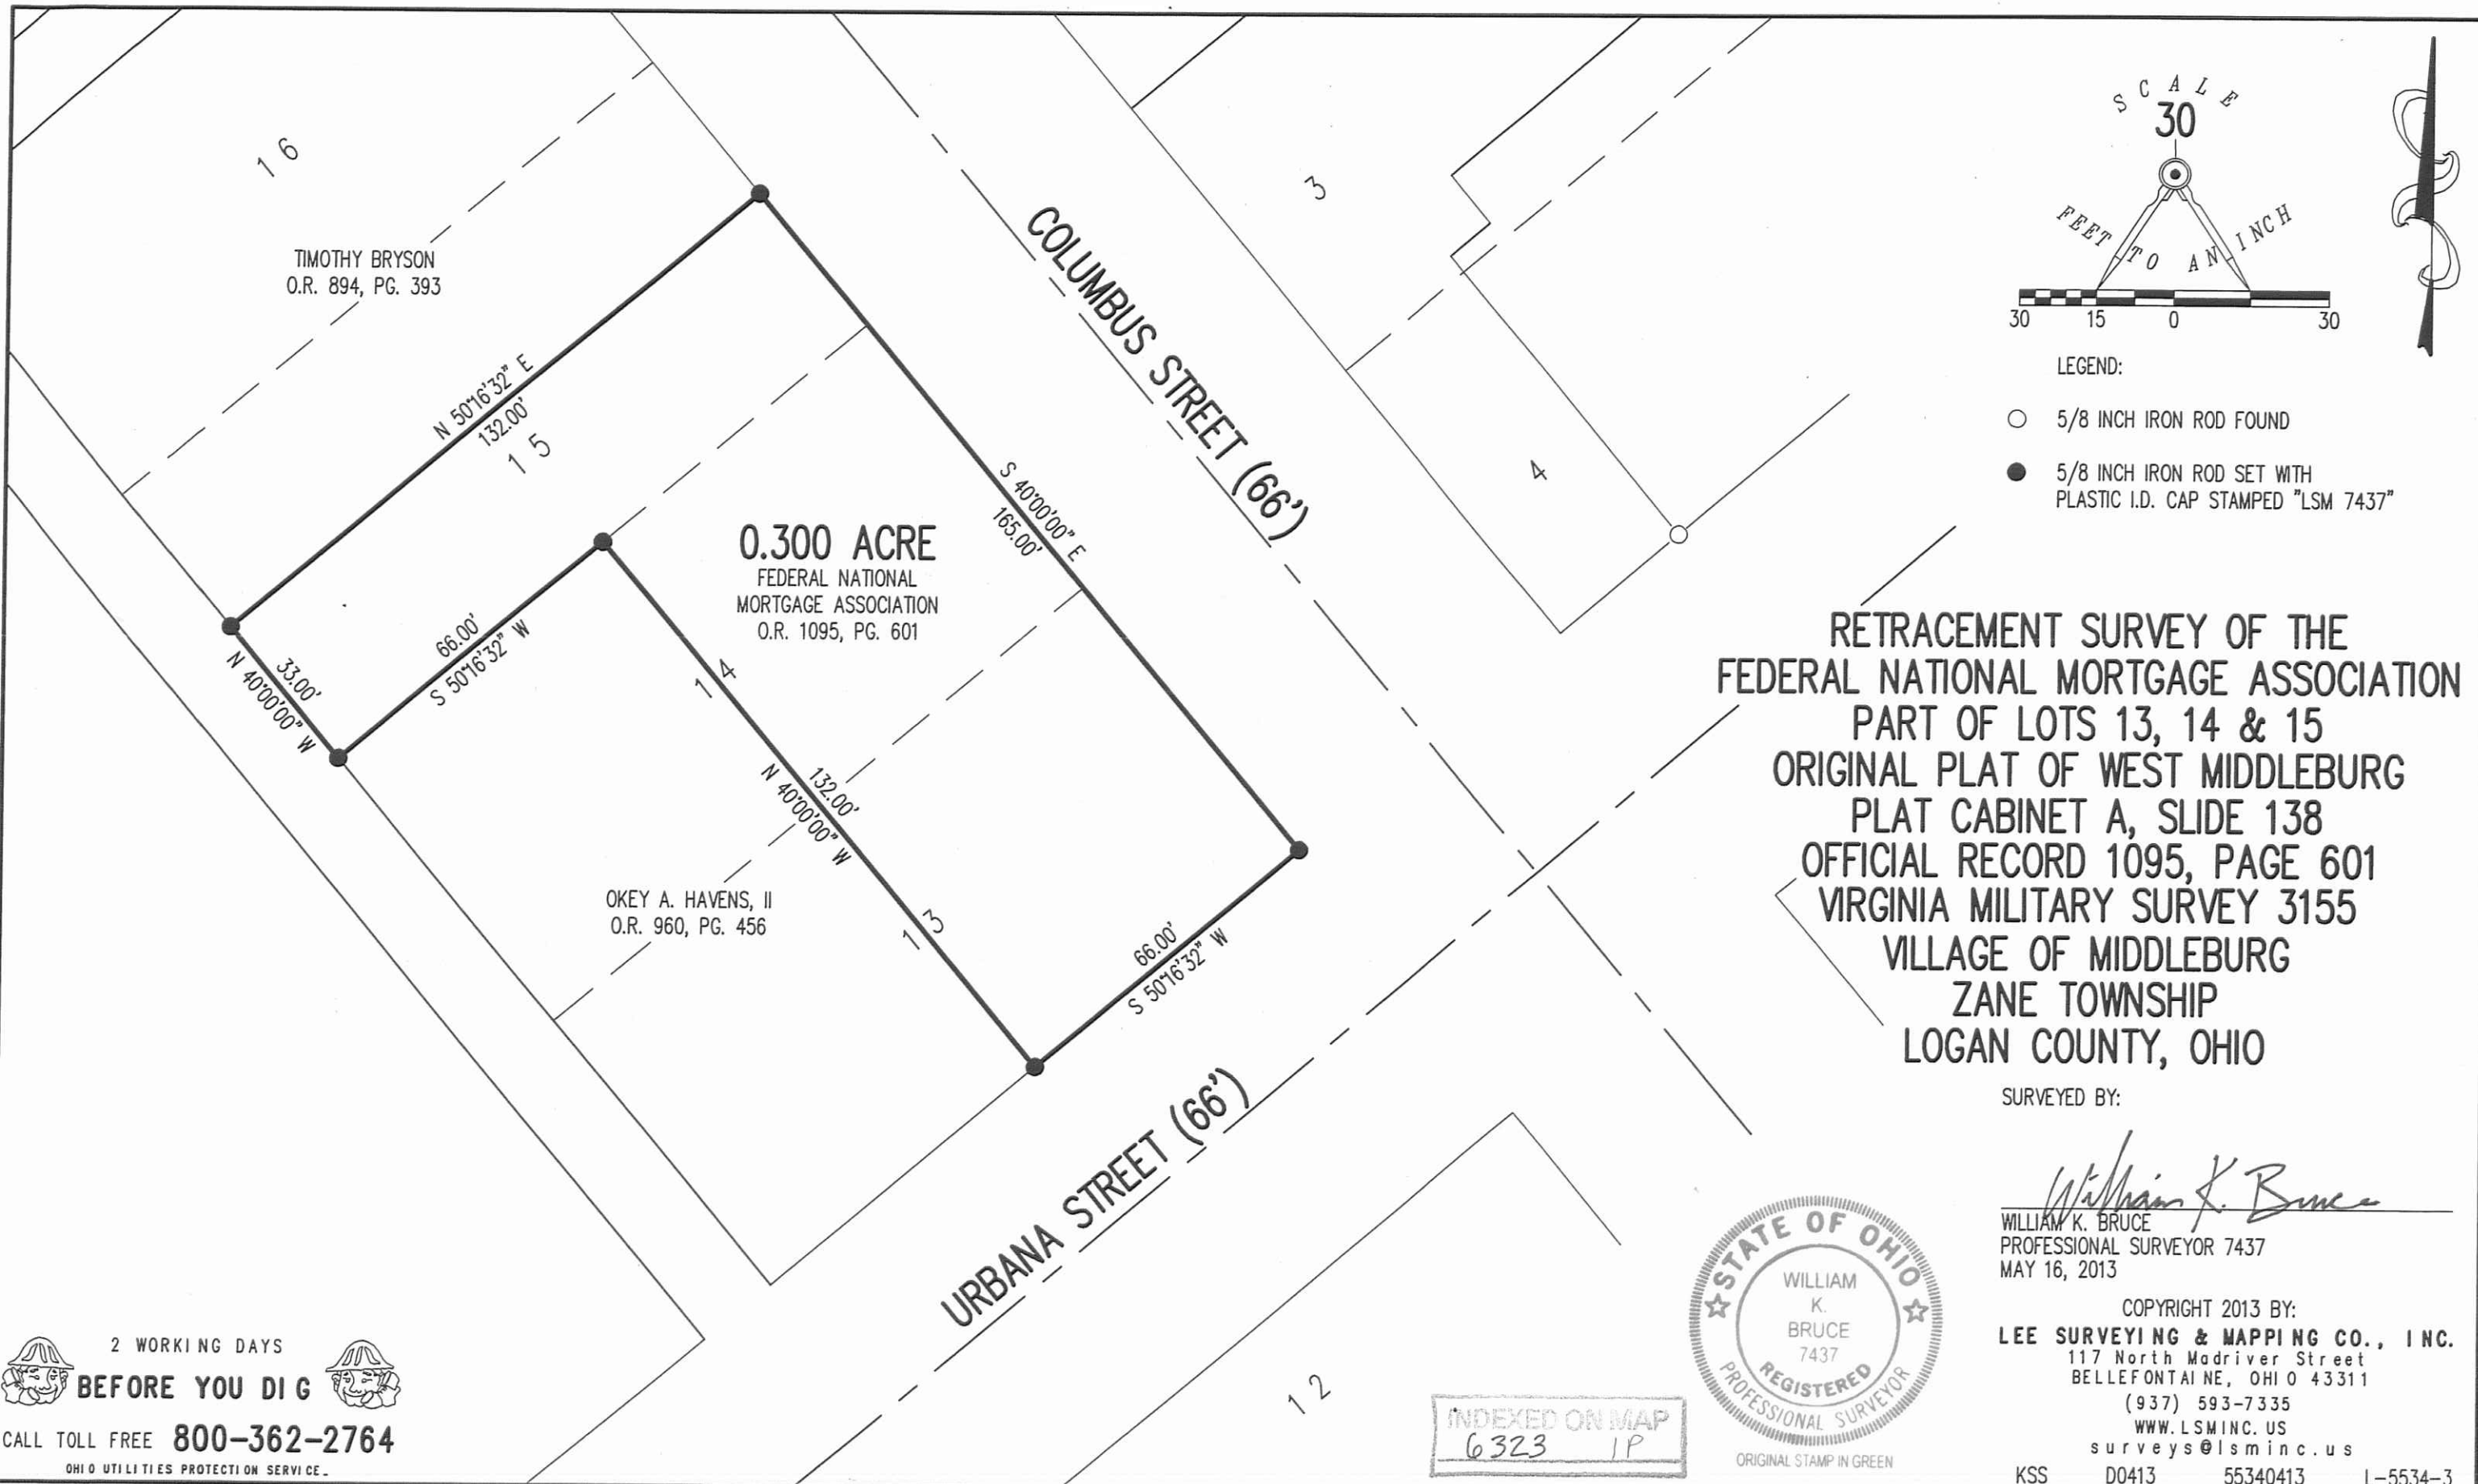

TIMOTHY BRYSON
O.R. 894, PG. 393

OKEY A. HAVENS, II
O.R. 960, PG. 456

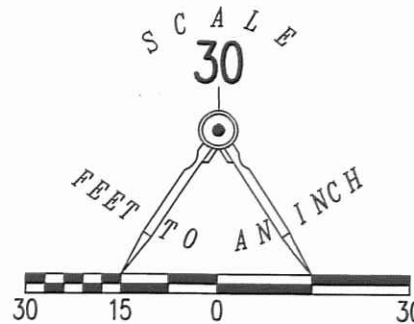

- LEGEND:
- 5/8 INCH IRON ROD FOUND
 - 5/8 INCH IRON ROD SET WITH PLASTIC I.D. CAP STAMPED "LSM 7437"

RETRACEMENT SURVEY OF THE
FEDERAL NATIONAL MORTGAGE ASSOCIATION
PART OF LOTS 13, 14 & 15
ORIGINAL PLAT OF WEST MIDDLEBURG
PLAT CABINET A, SLIDE 138
OFFICIAL RECORD 1095, PAGE 601
VIRGINIA MILITARY SURVEY 3155
VILLAGE OF MIDDLEBURG
ZANE TOWNSHIP
LOGAN COUNTY, OHIO

SURVEYED BY:

William K. Bruce
WILLIAM K. BRUCE
PROFESSIONAL SURVEYOR 7437
MAY 16, 2013



COPYRIGHT 2013 BY:
LEE SURVEYING & MAPPING CO., INC.
117 North Madriver Street
BELLEFONTAINE, OHIO 43311
(937) 593-7335
WWW.LSMINC.US
surveys@lsminc.us

INDEXED ON MAP
6323 1P

2 WORKING DAYS
BEFORE YOU DIG
CALL TOLL FREE **800-362-2764**
OHIO UTILITIES PROTECTION SERVICE

KSS D0413 55340413 L-5534-3