



Stanley Survey (Monroe Twp)

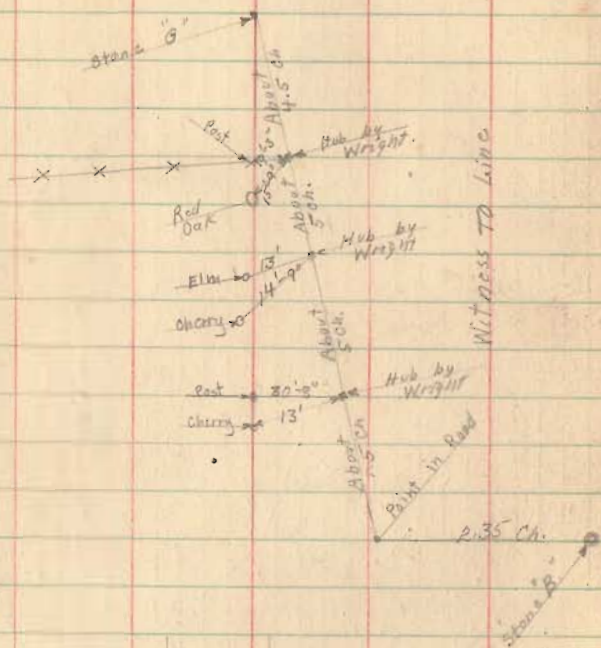

Reference To Stans and Iron

June-2-1924
Clear
F. Wright
Ed. Cor 2. 70

Survey { 10778
10718
10719

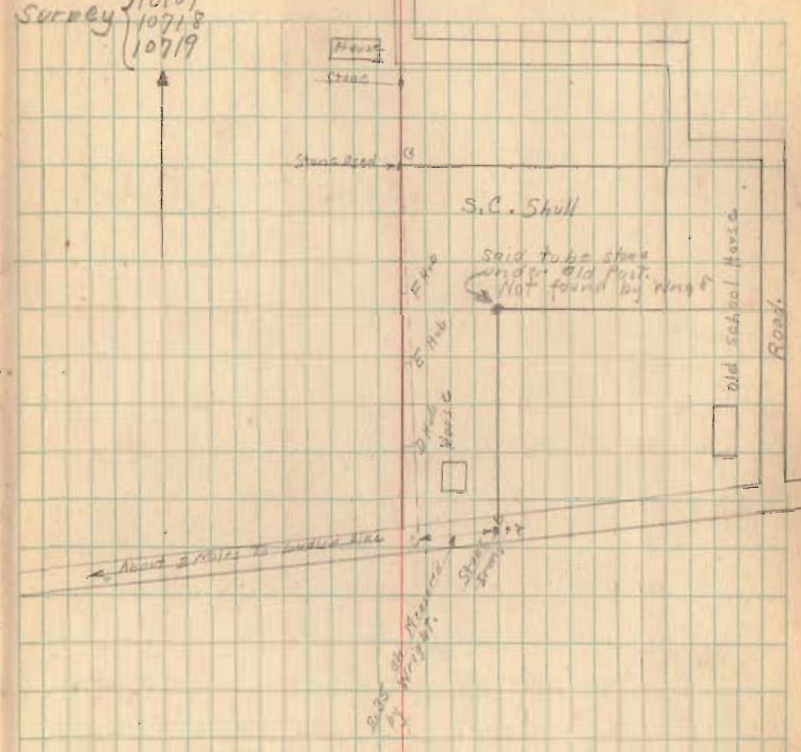

Run line C & as directed
It is my opinion this should
be an old fence line. Complete
survey not made.

80
INDEXED ON MAP