


Ida Hicks survey Monroe. Twp. ⁵

April 1, 1930

J.S. Crane

A.M. Renick

Survey 3222 Monroe

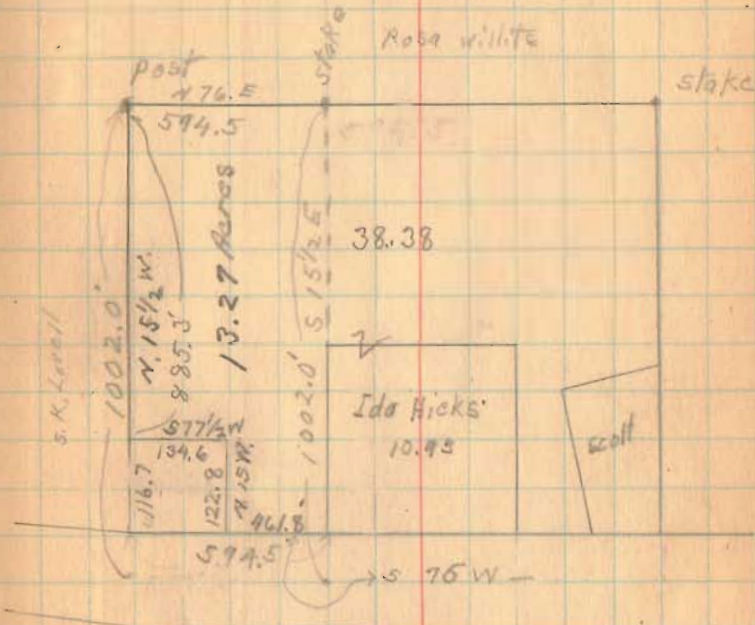

1186

INDEXED ON MAP