





Stave
 0' Our East side Ludlow road on Co. line
 1' Set 10 feet back and 10 feet north of section corner
 2' on line 190 feet east of quarter corner
 3' on section corner

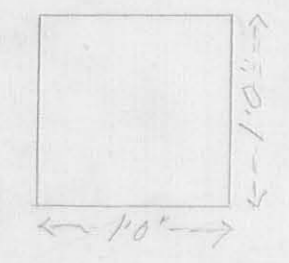

Stones are squared Bedford Limestone

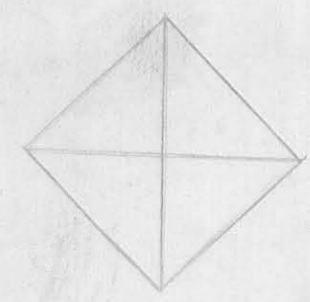

Section A-B

PLAN OF MONUMENTS
 Placed on line between
 LOGAN AND CHAMPAIGN
 COUNTIES
 1906.
 W.H.E.

1269 IP
 INDEXED ON MAP

10

R XIII. TV.

PLAN 1086 G-11

G-11