

Road 146

Monre - Zane - Perry

50' Picknelltown Pike Free Turnpike Record 5 Page 155
1880
Book A page 88
Profile Vault.

28+00

21+00

14+00

7+00

6+52

6+00

Left only.

Right only

Left Only


1+00

Monuments 25' from \perp for 50' road

1535

INDEXED ON MAP

Jan-12-1934
Thomson Mt. 31
Wright
Cranz
DeGon
Mills
Rothfelder

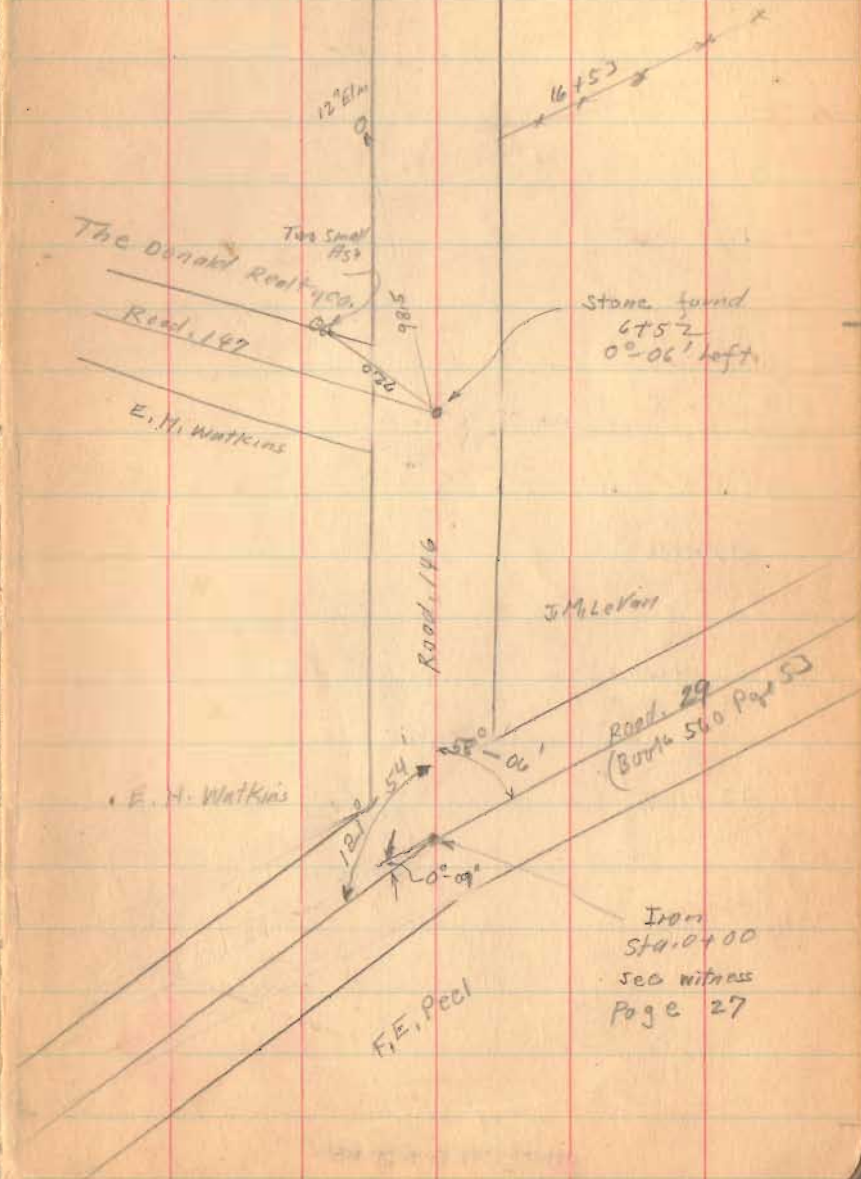

Road 146

44+70

39+00

33+09

1535
INDEXED ON MAP

Iron
44+70
1°-0' Right



Samuel Benton

X 44+27

The Donald Realty Co

Lane 35+24 ±

N. 85° E.
N. 85° E.

15' Post

Q 44.65
N 26 E.

Q 29.40
Wild cherry
N 62 W

Iron
33+09
0°-45' left

X 31+30 X

172-39

33

Samuel Benton

X 44+93
Ben Stanley

Road 1146

72+00

65+00

59+00

57+76

Tap Line Left only

56+95

Right only at Pl.


56+61.38

56+61.38

Right Tap Line Man

52+00

1535
INDEXED ON MAP

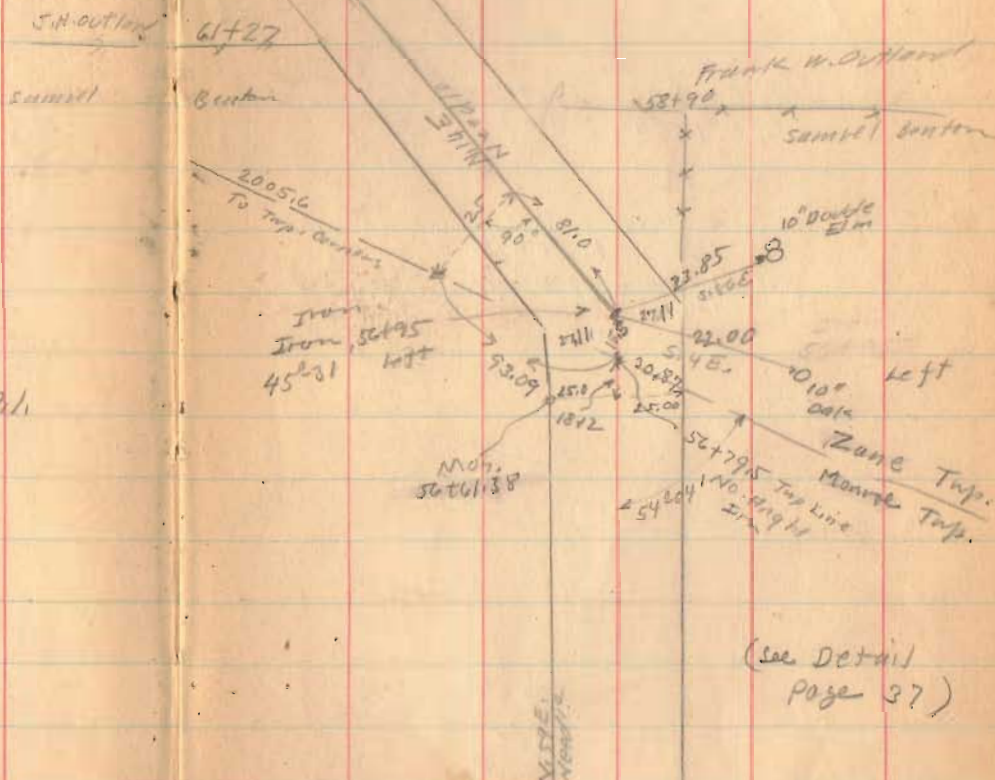

Jan-17-1934
Cold
Wing 4T
Orange
Dugan
Mills
Rothschilder

(see Detail
page 37)

Road, 146 (Detail of Trp line)
(NOT TO SCALE)

$$\begin{array}{r} .009264117 \\ 7243 \overline{) 67100} \\ \underline{65187} \end{array}$$


$$0^\circ - 32' -$$

$$sec = 1.00$$

2005.6 - 18.58
 3968.1 - 36.76
 5104 - 47.28
 7243 - 49.10



1535
 INDEXED ON MAP

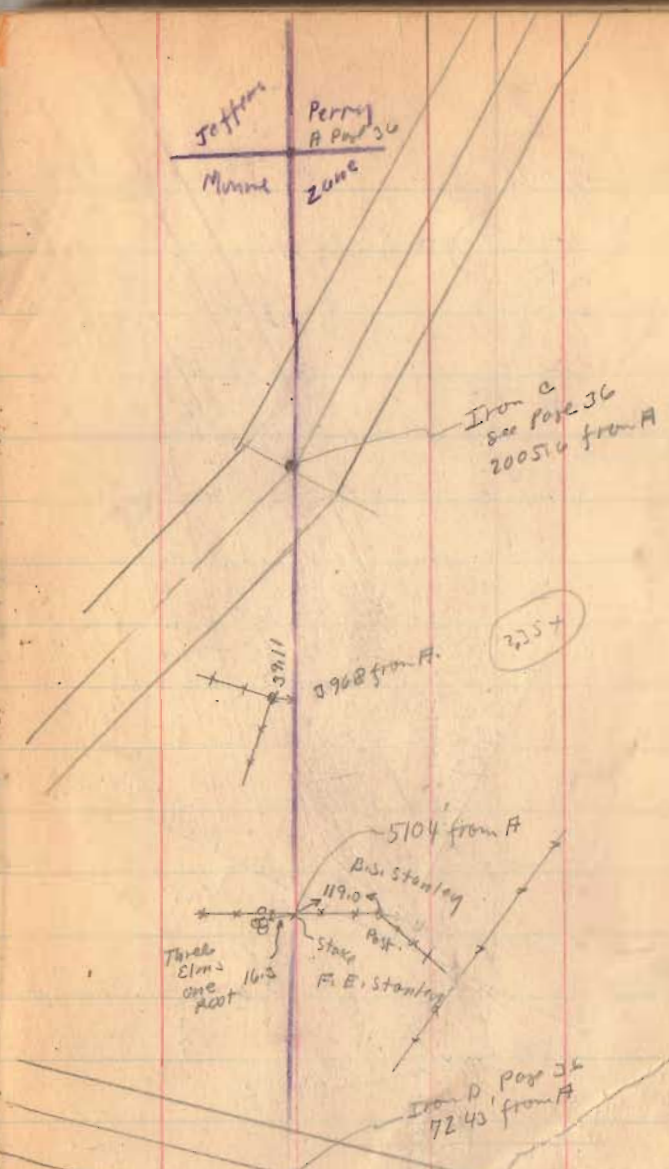

Road. 146
(Detail of Tap. Lines)

Jefferson
Monroe

Perry

Zone

