


April 22-1944  
clear & cool.

Wilgus  
Dadson  
Kaysor  
Detrick

Road No 28 south of Riekrelltown 74

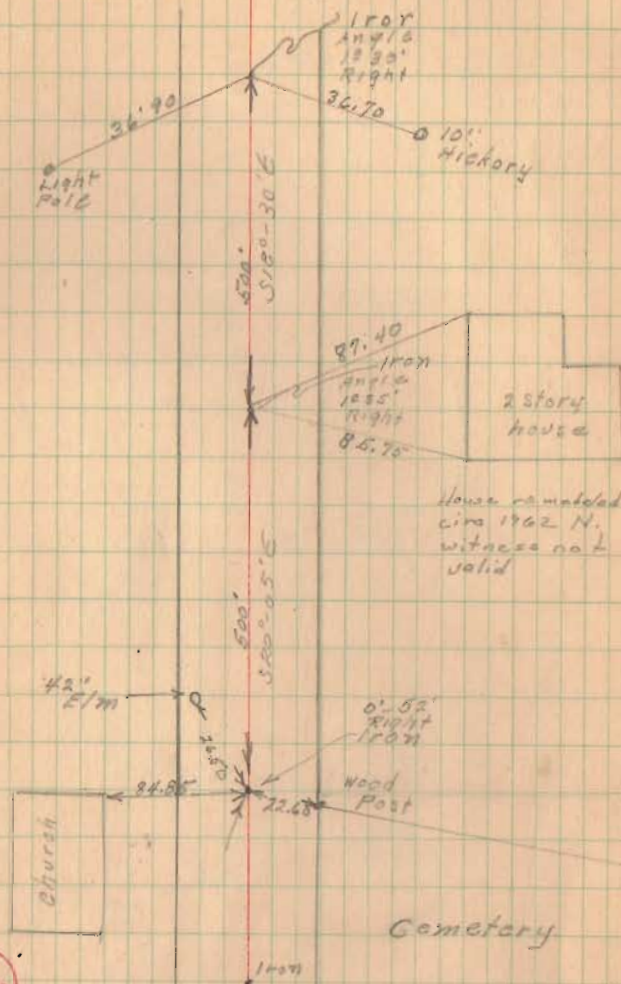

House completed  
circa 1962 N.  
witness not  
valid

D. N. [unclear]

4392

INDEXED ON MAP




Rd 28 (Contd)

75

Road No 28

Monument Road No 28

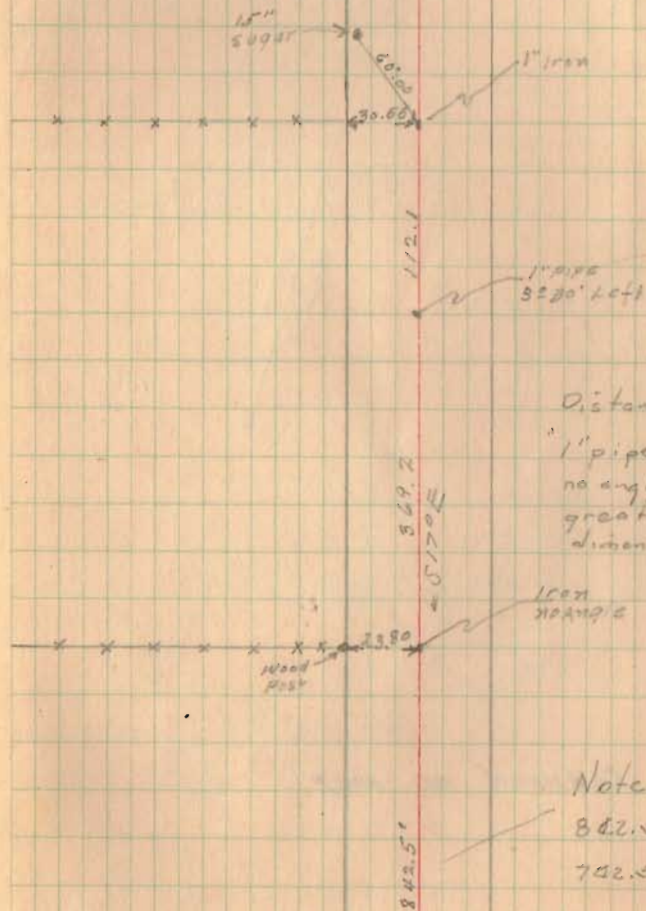

Distance between  
"1" pipe" + "1" iron  
no angle is  $100'$   
greater than  
dimension shown.  
4 June '68  
C.N.

Note

$842.5'$  measures

$102.5'$  4 June '68  
C.N.