

Received 9-24-93

LESLIE H. GEESLIN
REGISTERED SURVEYOR NO. 5248
P.O. BOX 274
RUSHSVLVANIA, OHIO 43347
TELEPHONE: (513) 468-2793

SMITH SURVEY

September 23, 1993

The following described real estate situated in the State of Ohio, County of Logan, Township of Monroe, being part of Virginia Military Survey 12099 and more particulalry described as follows:

Beginning at a 5/8 inch iron bar set in the centerline of Township Road 166 that is N. 9° 00' 00" E. 39.88 feet from the southwest corner of Victor Smith's 5.51 acre tract as described in D. B. Vol. 239 Page 436.

Thence with said centerline N. 9° 00' 00" E. 180.00 feet to a 5/8 inch iron bar set.

Thence N. 74° 34' 43" E. 292.36 feet to a 5/8 inch iron bar set.

Thence S. 9° 00' 00" W. 180.00 feet to a 5/8 inch iron bar set.

Thence S. 74° 34' 43" W. 292.36 feet to the place of beginning.

Containing 1.100 acres more or less of which approximately 0.103 acre is in the right-of-way of Towship Road 166.

The above described 1.100 acre tract being out of Victor Smith's 5.51 acre tract as described in D. B. Vol. 239 Page 436.


Bearings are based on an assumed bearing (N. 9° 00' 00" E.) for the centerline of Township Road 166 in this field survey by Leslie H. Geeslin, Reg. Surveor 5248 on September 23, 1993.



Leslie H. Geeslin

INDEXED ON MAP
8842 ID

VICTOR SMITH
5.51 AC.
D.B. VOL. 239 PG. 436

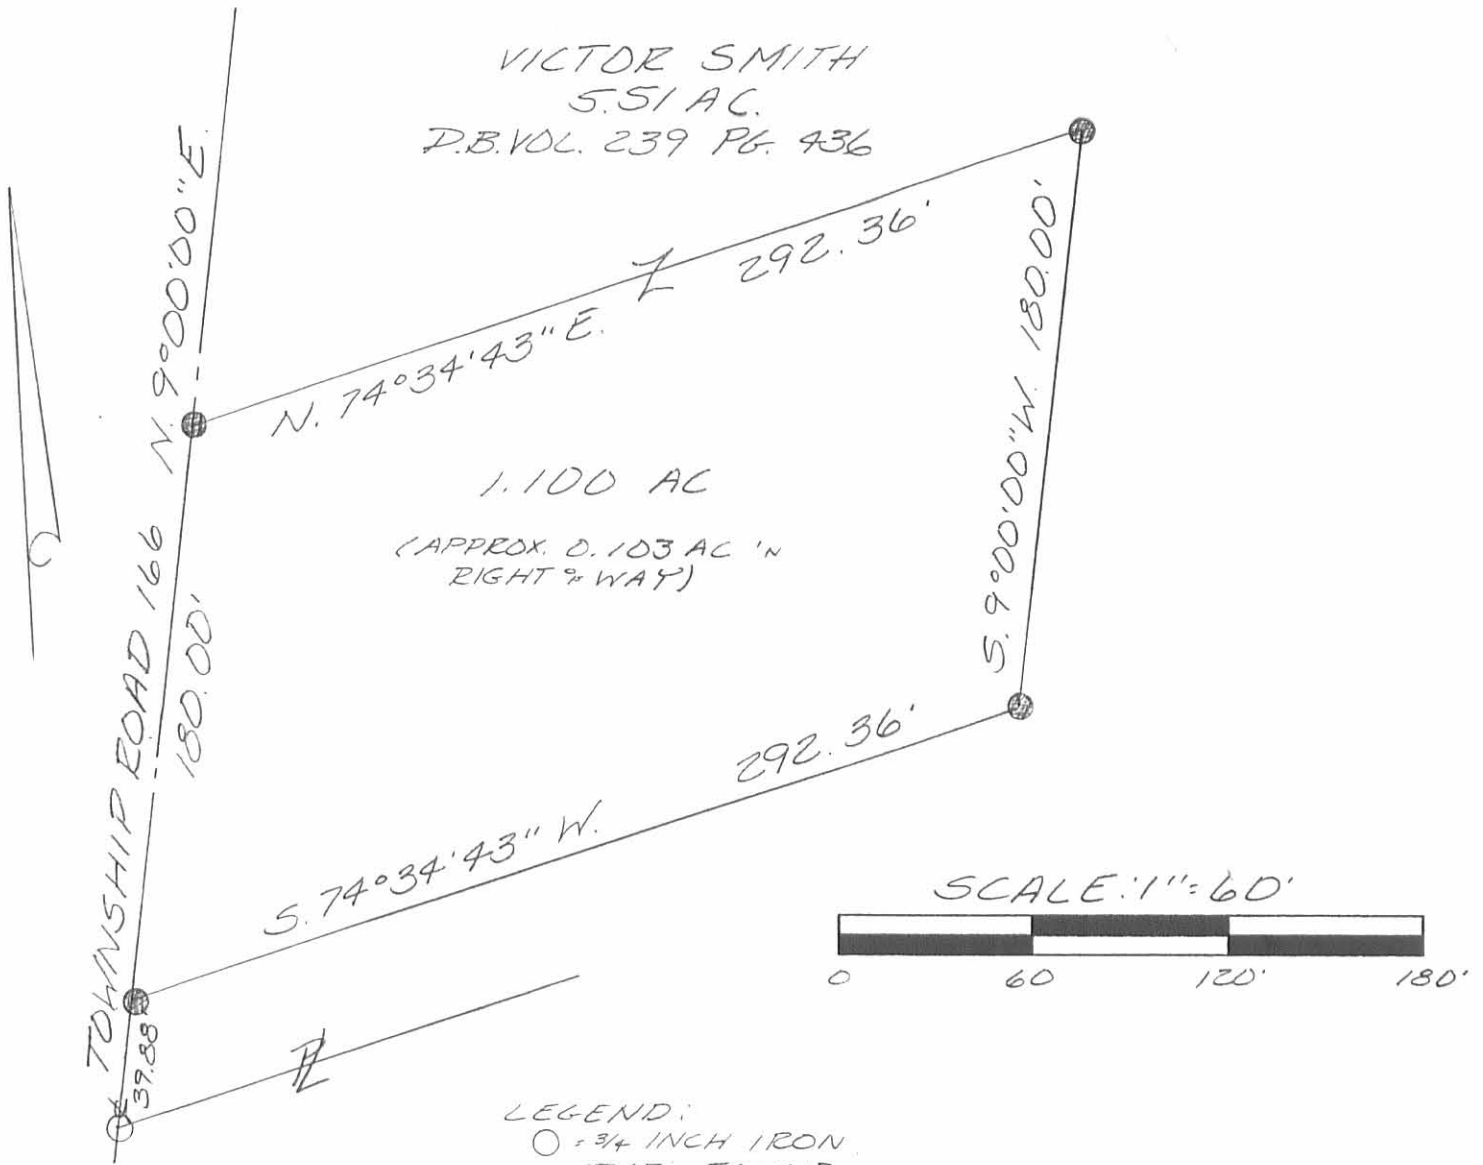

LEGEND:
○ = 3/4 INCH IRON
BAR FOUND
● = 5/8 INCH IRON
BAR SET

SURVEY OF 1.100 ACRES OUT OF 5.51 ACRES
IN VIRGINIA MILITARY SURVEY 12099,
MONROE TOWNSHIP, LOGAN COUNTY,
OHIO FOR VICTOR SMITH ON
SEPTEMBER 23, 1993



Leslie H. Geeslin
LESLIE H. GEESLIN
RUSHSVYLVANIA, D
(513) 468-2793

INDEXED ON MAP
8842 1P