

Road 144 Perry Tap

60' Original Road. Comm Journal 6 Page 26
1838 95

50' Pike Record. East Liberty Pike
Free Turnpike Record No. 2 Page 87
1870

- A - Dug for Iron No Luck.
 E " " " " "
 F " " " " " sta. 32+00
 G " " " " " "
 B Placed 3/4" Iron 24" long
 C " " " " " sta. 12+79
 D " " " " " (Top of Hill)
 sta. 25+33

Set stake 25' Left 25' Right C - D


Set stakes for Arthur Fence 25' from E

- H. Stone found.
 J Stone found.
 K. Iron found Harrison Tooth Placed 3/4" Iron 30" long
 L Iron found.

See Page 27 for witnesses
 to J. & L.

1476

INDEXED ON MAP

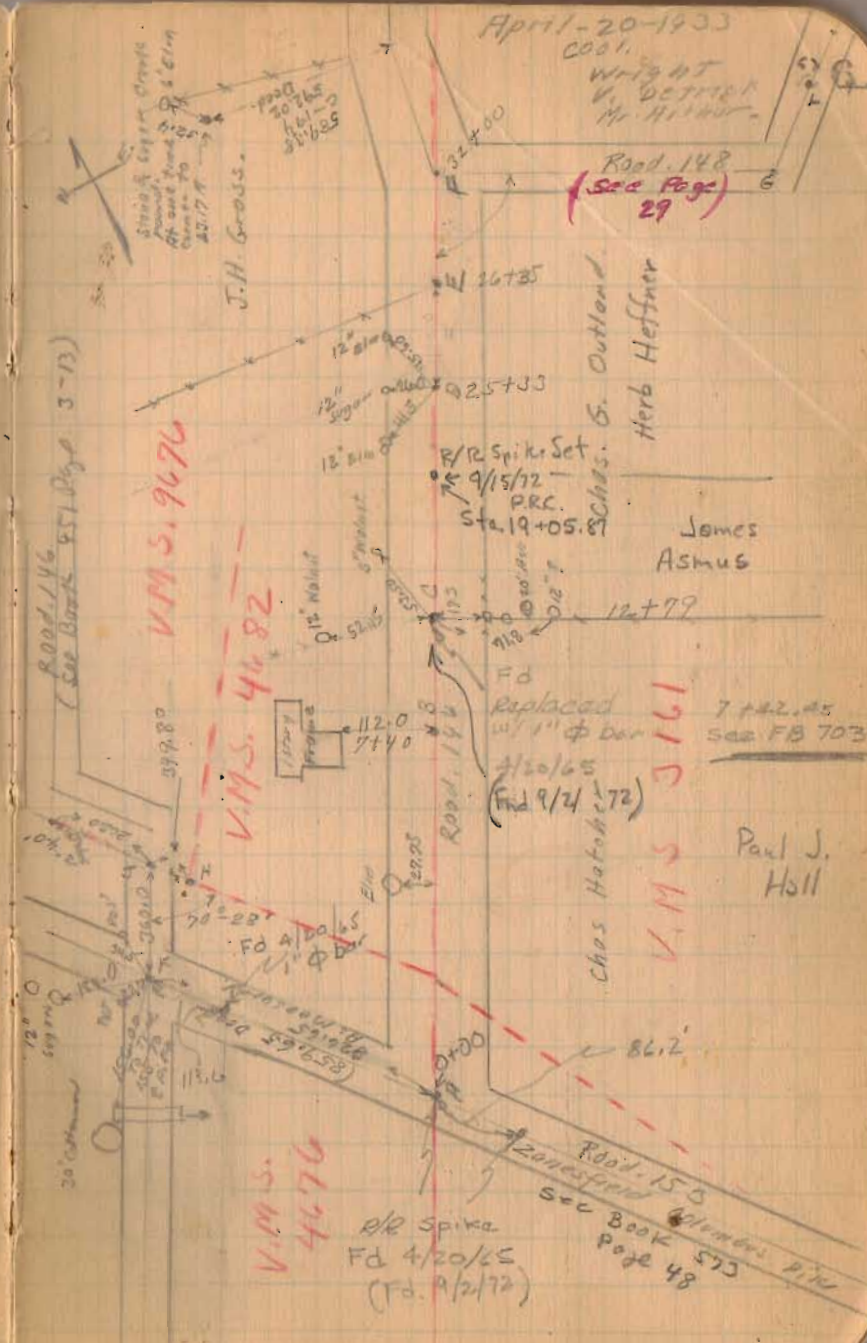

April-20-1933
 Cool,
 Wright
 V. Detroit
 Mr. Hillier.

Road 148
 (See Page 29)

VM S. 9676

VM S. 4682

VM S. 5161

VM S. 4676

Chas. G. Outland
 Herb Heffner

James
 Asmus

7+42.45
 See FB 703

Paul J.
 Hill

R/R Spike Set
 9/15/72
 P.R.C.
 Sta. 19+05.87

R/R Spike
 Fd 4/20/65
 (Fd. 9/2/72)

Road 150
 Sec Book 573
 Page 48

Road 148

Perry Tap V.M.S. 3161

(See Page 26)

End
8+25
Iron

No Road Record Found

Staked $\frac{20}{15}$ from
 $\frac{40}{30}$ for
30' Road.

Trustees To Get Right-of-way.

Iron
See Page 26
No Angle
 $7 + 80.15$

8+25

~~6+00~~

P.T.

~~4+80~~

4+65.92 P.C.

3+00

Length 825 Feet

Length 0.156249 Miles

Length 0.16 Miles

0+50

For R/W
posts

Sta. 8+25 To Road 153
(Near Middleburg) vacated

See Commissioners Journal
2 Page 199

See Plan

X-198A


~~36~~

Aug. 31-1937

Clear - Worm
Pile 9 ft
5' width
W. Area

29

Length 825 Feet

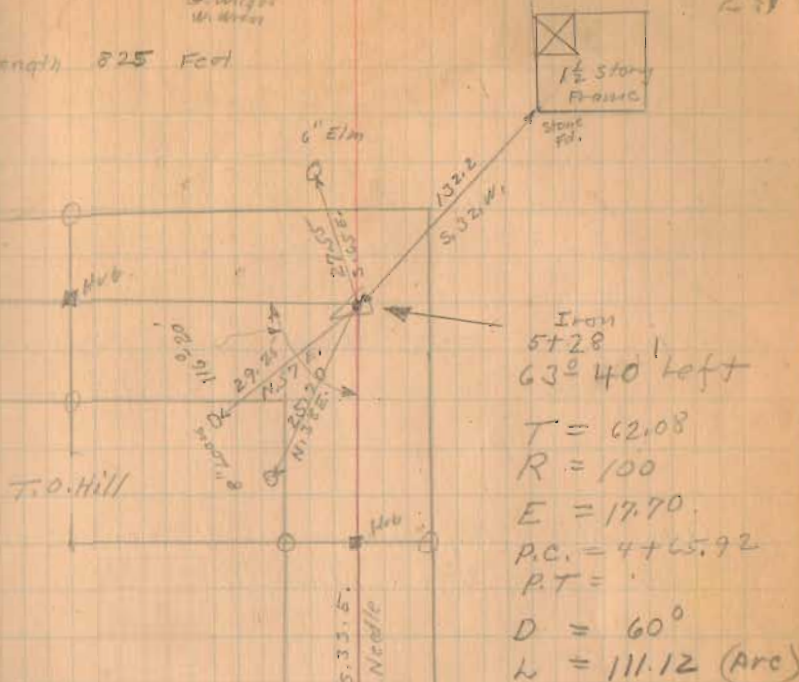

T.O. Hill

10° pole
Q

Road 144
N. 40°
W. 20'

1476
INDEXED ON MAP

0+00
Iron
32.0° from Road No. 153

9.15 15° pole
Q

C.G. Outland

East Liberty Pike
Road No. 144

Needle
N. 58 E