



Road 155 - East Liberty - Perry TWP.
VMS 4689

May. 27, 1945
E. Cone
G.W. 30

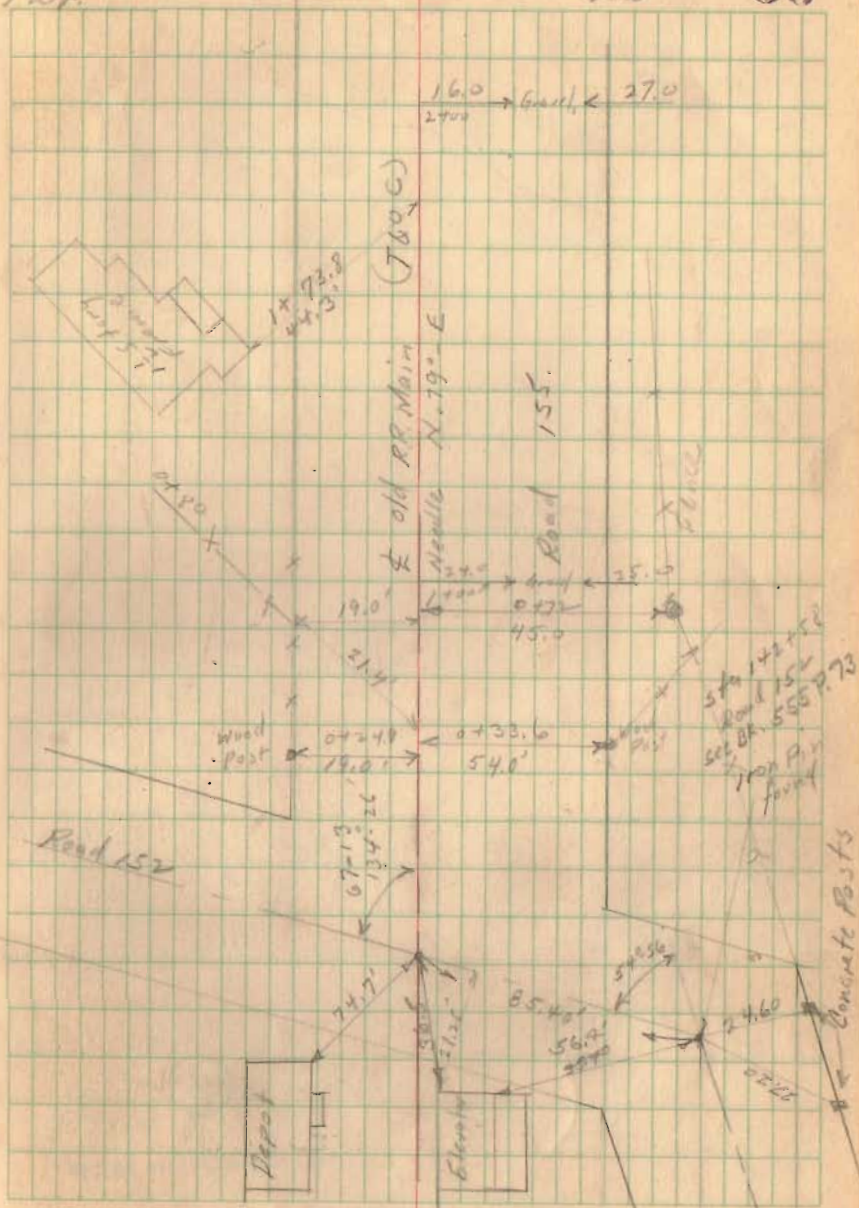


1820

INDEXED ON MAP

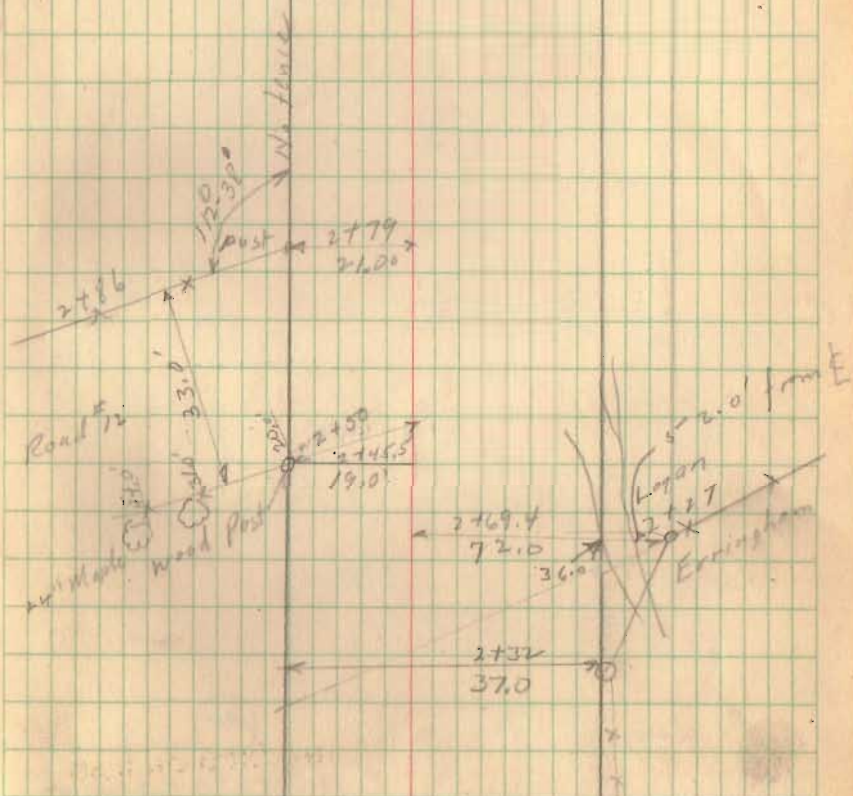



1820









INDEXED ON MAP

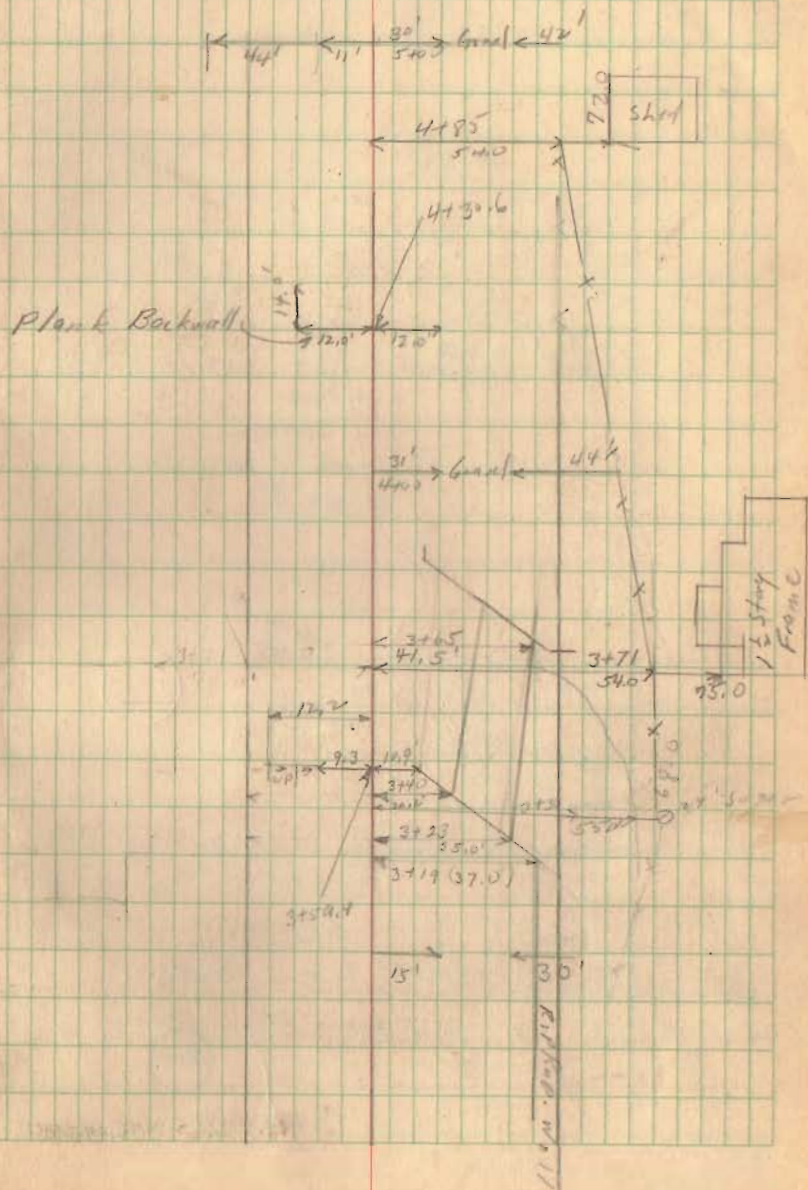

1020

INDEXED ON MAP

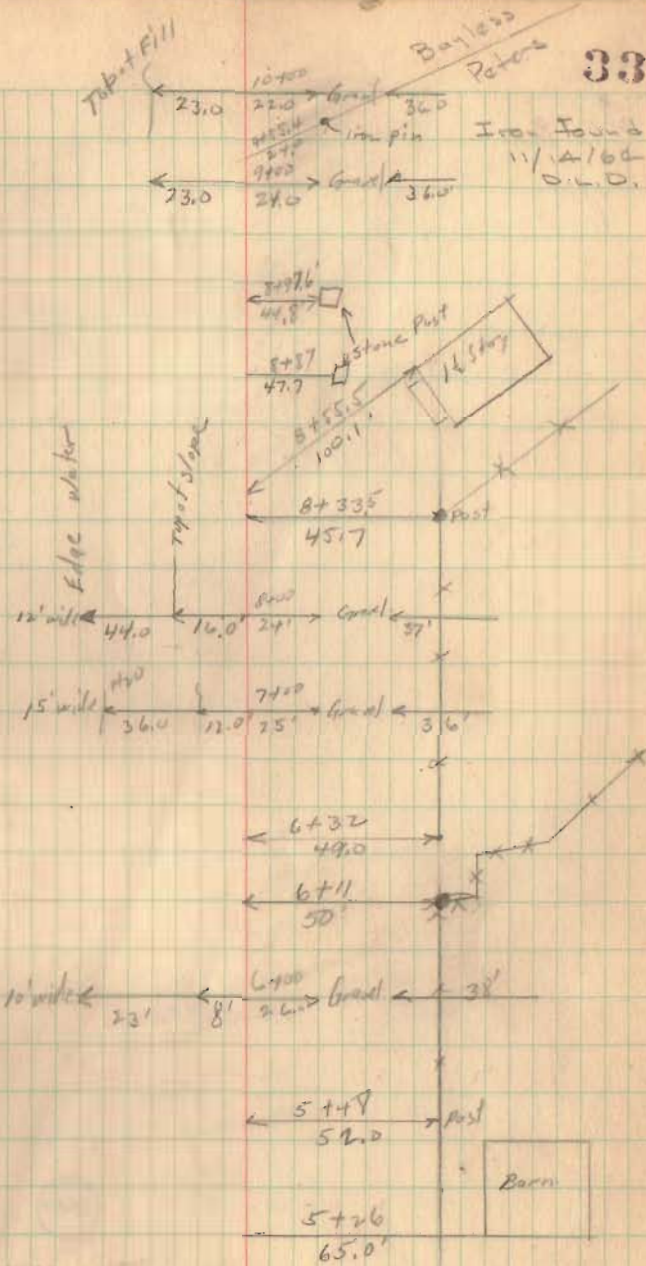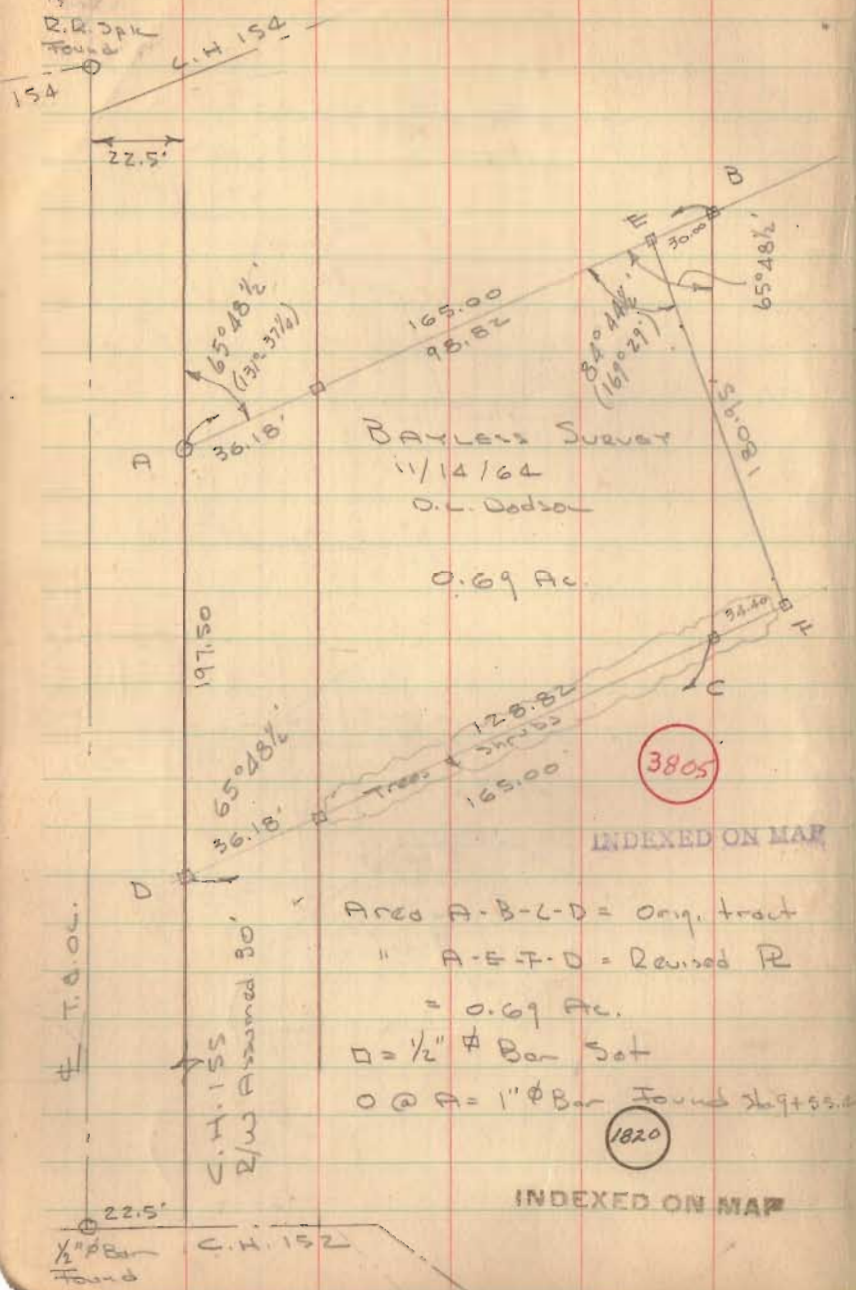

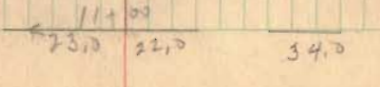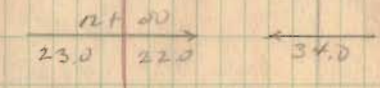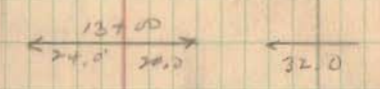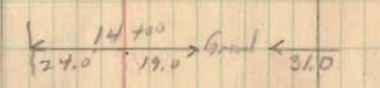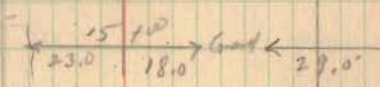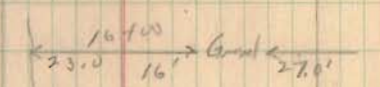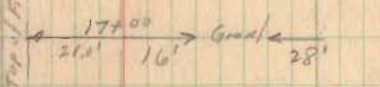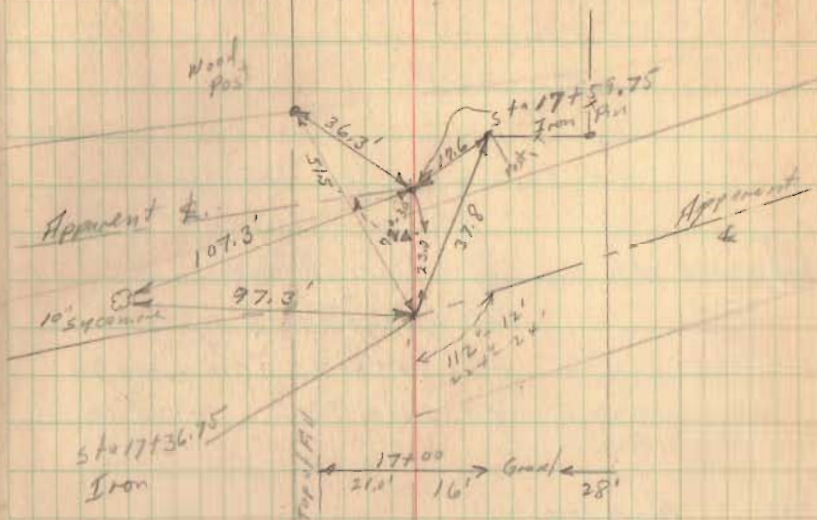

1820

INDEXED ON MAP