


Road No. 129 - & Survey
 Jefferson Twp. and
 Perry Twp.


Party: M. Hand
 D. Dodson
 H. Haysler-8
 B. Brooke-8

Jan. 20, 1949
 Cold -

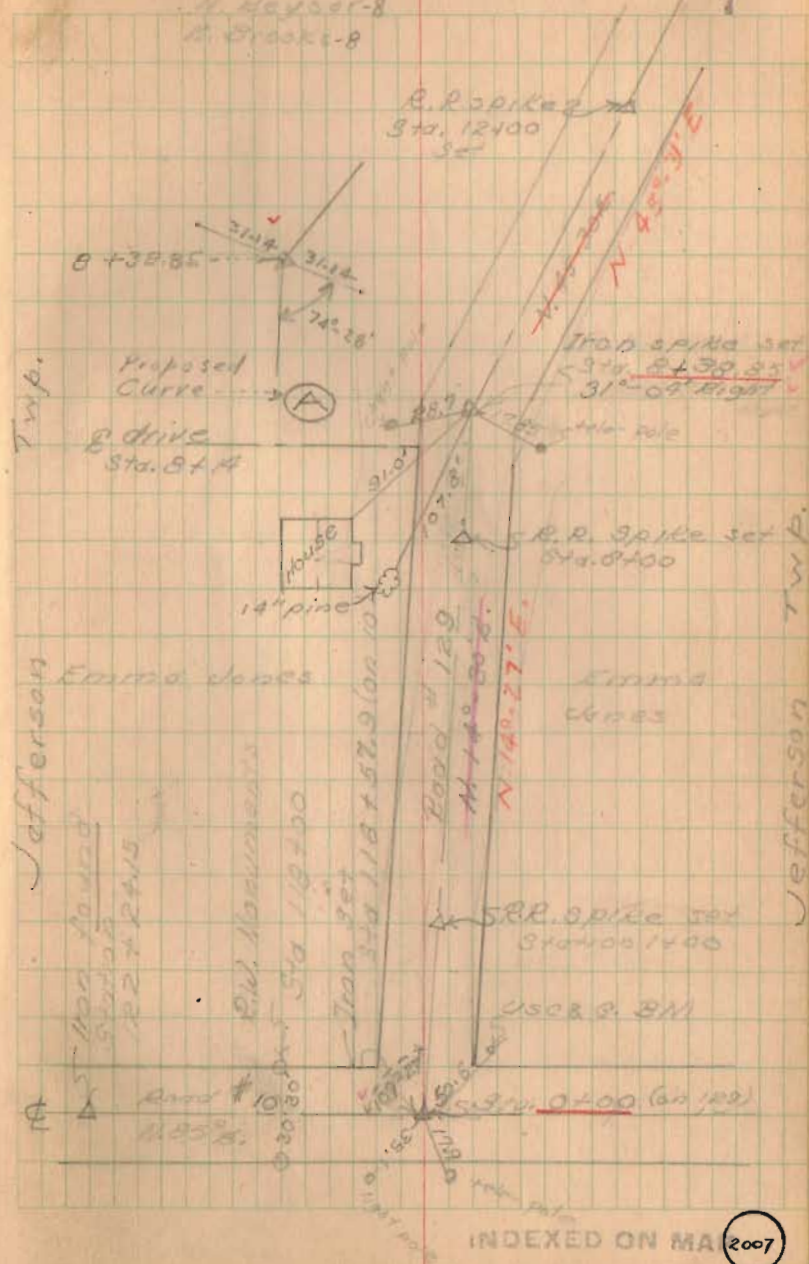

Road No. 129


(Cont'd.)

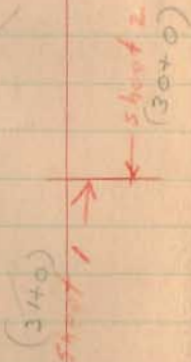

Party: Harold T.
 J. Dodson W
 H. Keyser S
 E. Sprock S

Jan 21, 1949
 Cold

8

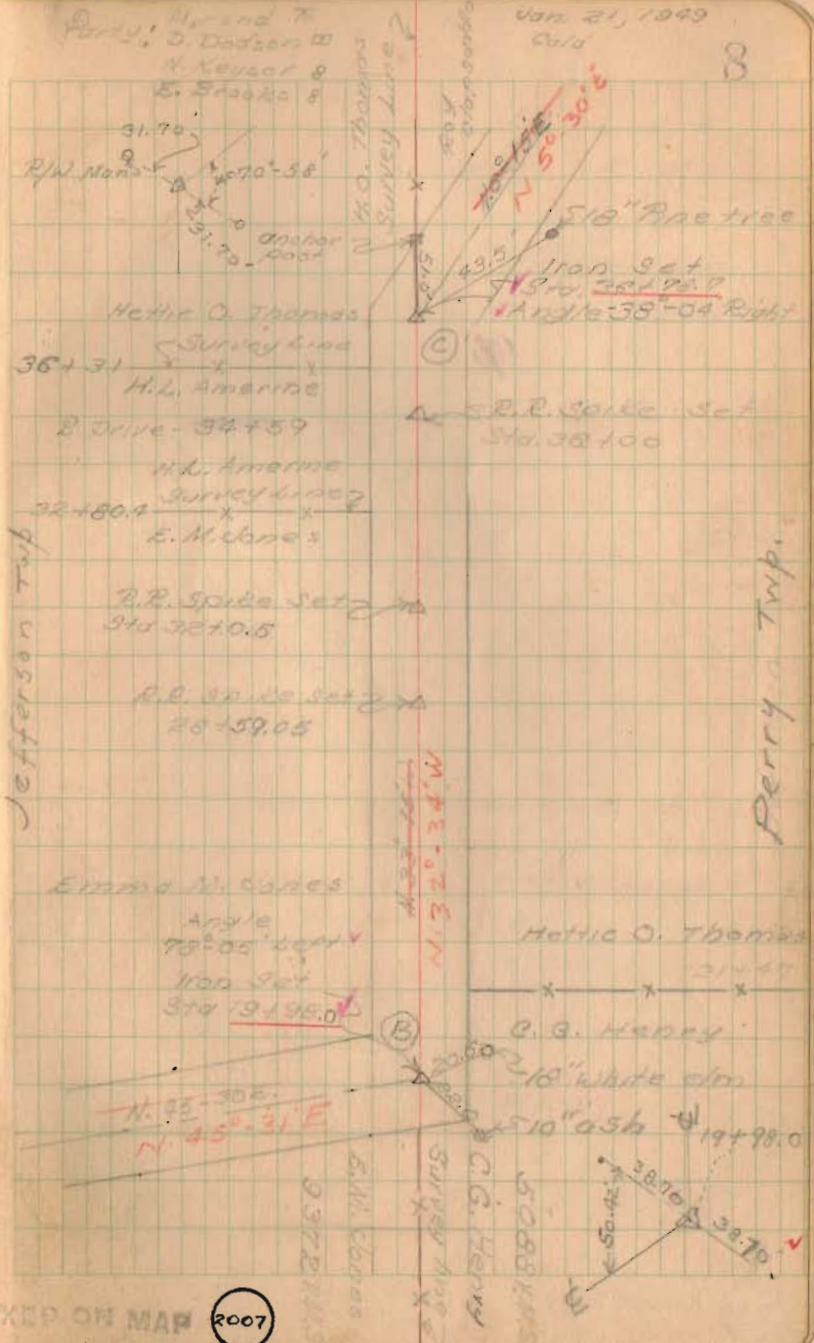

INDEXED ON MAP 2007

Road 129



Party: M. Hand
D. Dodson
N. Keyser

Jun. 25, 1949
Cold

9

N
↑

V.M.S. 2574

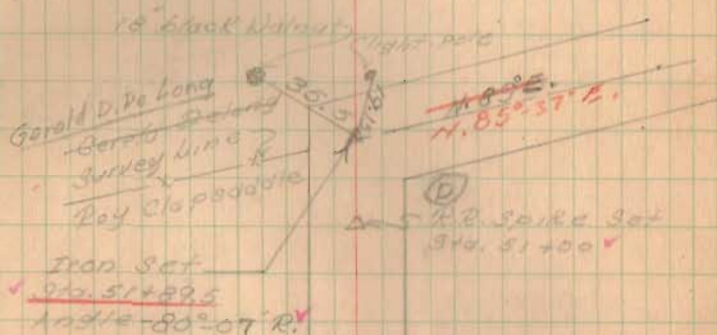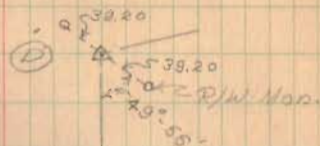

V.M.S. 5088

V.M.S. 5088

Roy Clapradle

Roy Clapradle
Herbie O. Thomas

N 5° 30' E

INDEXED ON MAP


2007

Rd # 120

Party - M. Hand
D. Mitchell
D. Dodson
B. Hemminger

6/7/49
Warm

12

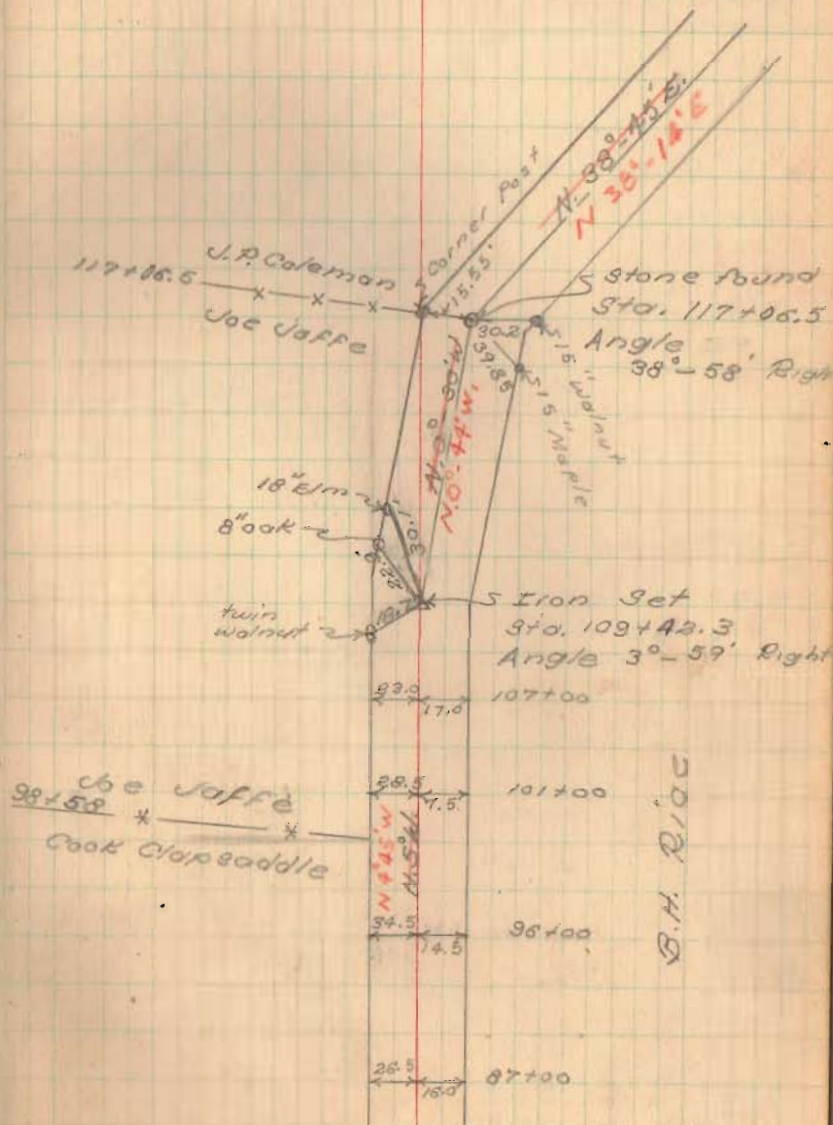


INDEXED ON MAP

2007

Rd. # 129

5/9/49
Warm 13

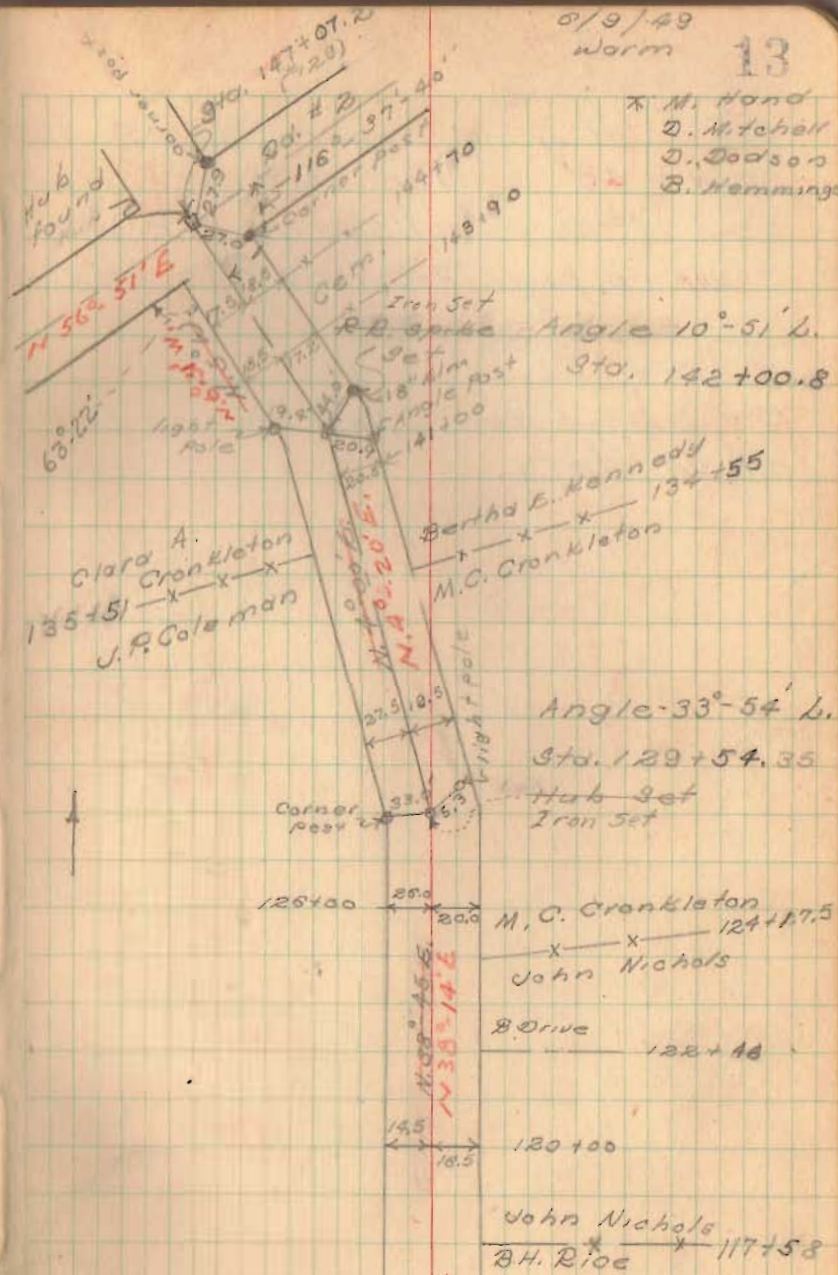

INDEXED ON MAP

2007