


East Liberty Elev. Co.
(cont'd)

Found the blacksmith shop on Herford was on the Elevator property, so gave Herford 14.68' feet as shown.

See next page for detail →

See pg. 72-73
See pg 74 for prop alley

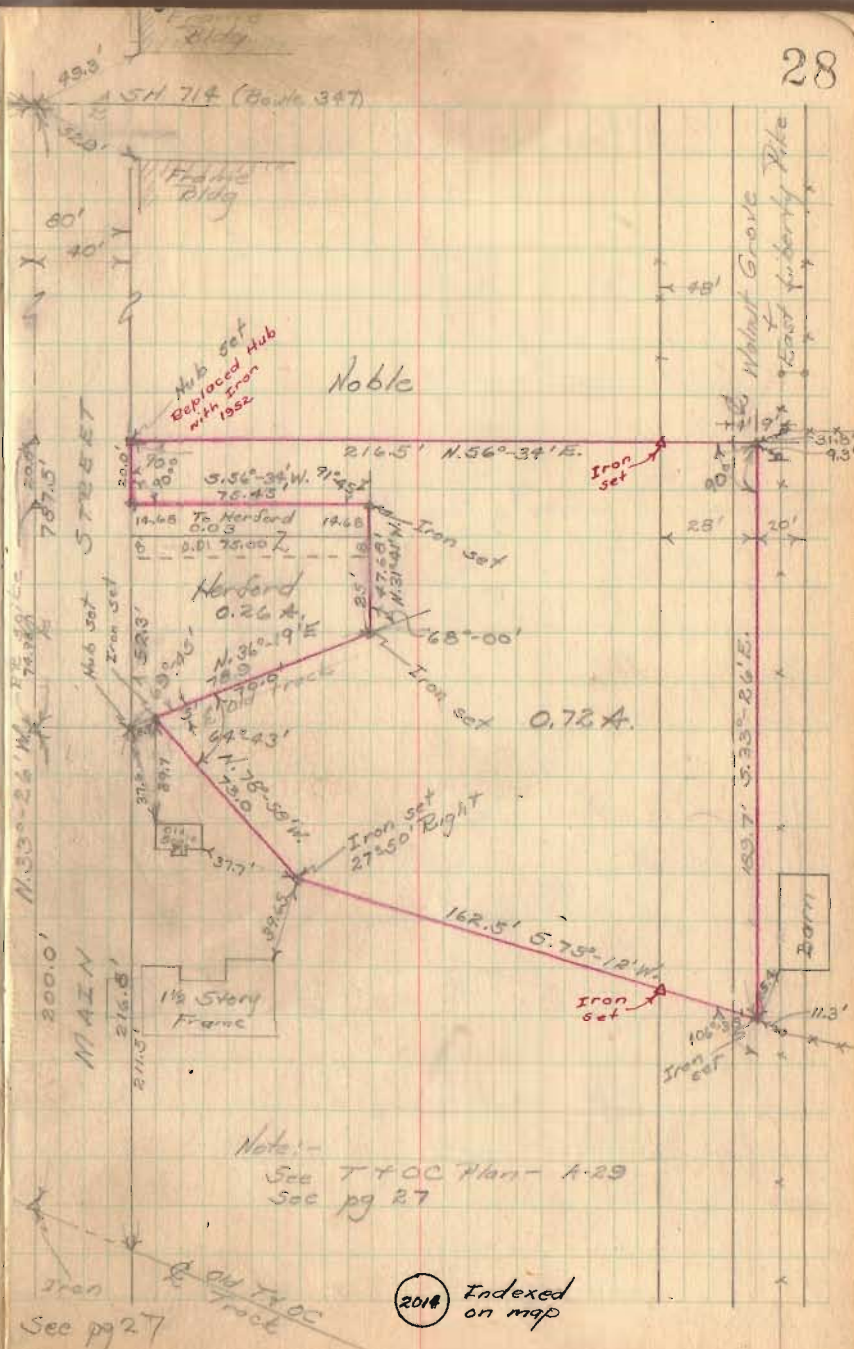

East Liberty Elev. Co.
(Contd)

Witnesses to various points

29

