


8247

4th Mo. April, 13th 1830 Survey No 129

Surveyed 100 acres of land for John Griffith assigned to on a military warrant of 2968 on the waters of Mill creek. Beginning at 2 Sugar trees, north east corner to Charles Porterfield's Survey No 9888 and north west corner to Lewis Talcoferro's land & others Survey No 9889 and corner to Survey No 9910 which corner is 161 6 1/2 poles from the head of a large gravelly spring, thence N 78 6 with the north line of Survey No 9889 (crossing a branch at 20 poles) to 3 beeches and 2 Sugar trees, in a county road.

from Garwood's mill to the big spring on the road to Sandusky, thence N 12 W 160 poles to a Sugar tree, beech small ironwood and hickory, thence S 78 W (crossing said road at 30 poles) 100 poles to a rock Sugar tree and beech in the east line of Survey No 9910; thence with said line S 12 E 160 poles (crossing a branch at 11 poles) to the beginning containing 100 acres in the South west corner of Bridge's & other's Survey No 9911.

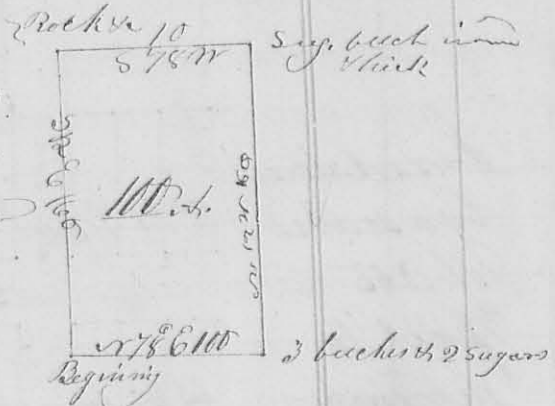


James Watkins } 66 James W. Marrison
David Hunt } C. S. L. G.
Jacob, Rosebrook in the

4th Mo. April, 15th 1830 Survey No 130

Surveyed and divided 150 acres of land, part of Survey No 4681 on the waters of Mad river, according to the directions of Josep H. Garwood, Joseph Stokes, and Alexander Lopez, commissioners appointed by the court of common Pleas at the April term 1830 on the petition of Lemuel Watkins and Mary his wife for partition of the estate of John Taylor dec'd. Beginning at a beech, cherry tree, Sugar tree (the cherry tree has been cut down), at the south east corner of Samuel Davis's Survey No 3216, thence S 75 6 (crossing a branch at 14 poles) 120.5 poles to an elm and Hackberry; thence S 15 W crossing road leading

111 From Zenasfield to Millford at 155 poles, 220 poles
 to a beech on a hill side, at the north easterly corner
 of Geo. Ream's land; thence $\text{ex } 5^{\circ} \text{ N}$, with his northerly
 line (crossing a branch

at 38 poles) 125 poles to a
 beech in the east line of
 Samuel Davis's said
 survey; thence with said
 line $\text{ex } 15^{\circ} \text{ E}$, crossing the
 road at 36 1/2 poles, 180
 poles to the beginning
 containing 150 acres off
 the west end of Thomas
 Shewalt's survey 11061—

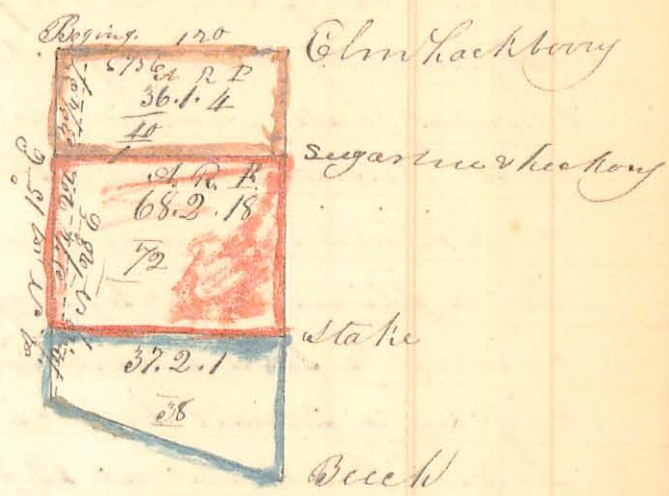

From the beech in east line of Davis's survey
 there is a line which runs $\text{ex } 20^{\circ} \text{ E}$, and striking
 off 1/2 acres of this tract, the title of which is
 controverted.— The first division line begins
 at a sugartree and small hickory in the east line
 53.1 poles from the cedar and Hackberry corner;
 thence $\text{ex } 75^{\circ} \text{ W}$ 120.5 poles to a stake in the west line
 to strike off 1.0 acres off of the north of this tract,
 3 acres woods and 27 poles of which is of the controverted
 title:— The 2nd line begins in the east 105.9 poles
 from the beginning of the first line and 65 poles
 from the south east corner of this tract; thence with
 the road $\text{ex } 69^{\circ} \text{ W}$ 120.8 poles to a stake in said road,
 36.5 poles $\text{ex } 15^{\circ} \text{ E}$ from the south west of this tract
 which stake is in the east line of Samuel Davis's
 said, setting off 3.8 acres of the south end of this
 tract which is shaded with green 1/2 acres of which
 is of the controverted title, and leaves 72 acres in the
 middle, which is encircled with red, 3 acres road
 and 22 poles of which is of the controverted title; it
 also embrace the farm and mansionhouse—

There is of a degree westerly variation from the original lines of
 of the survey and the division lines have been run to correspond
 therewith
 Geo. Watkins David Ream's Ex, James McCarren C.D., L.C.