


Surveyed for —
Frank E. Strayer

Pt. N.W. Qr. Sec. 2, T.1. R. 8

Pleasant Township.

Mar 2, 1909

(165)
INDEXED ON MAP

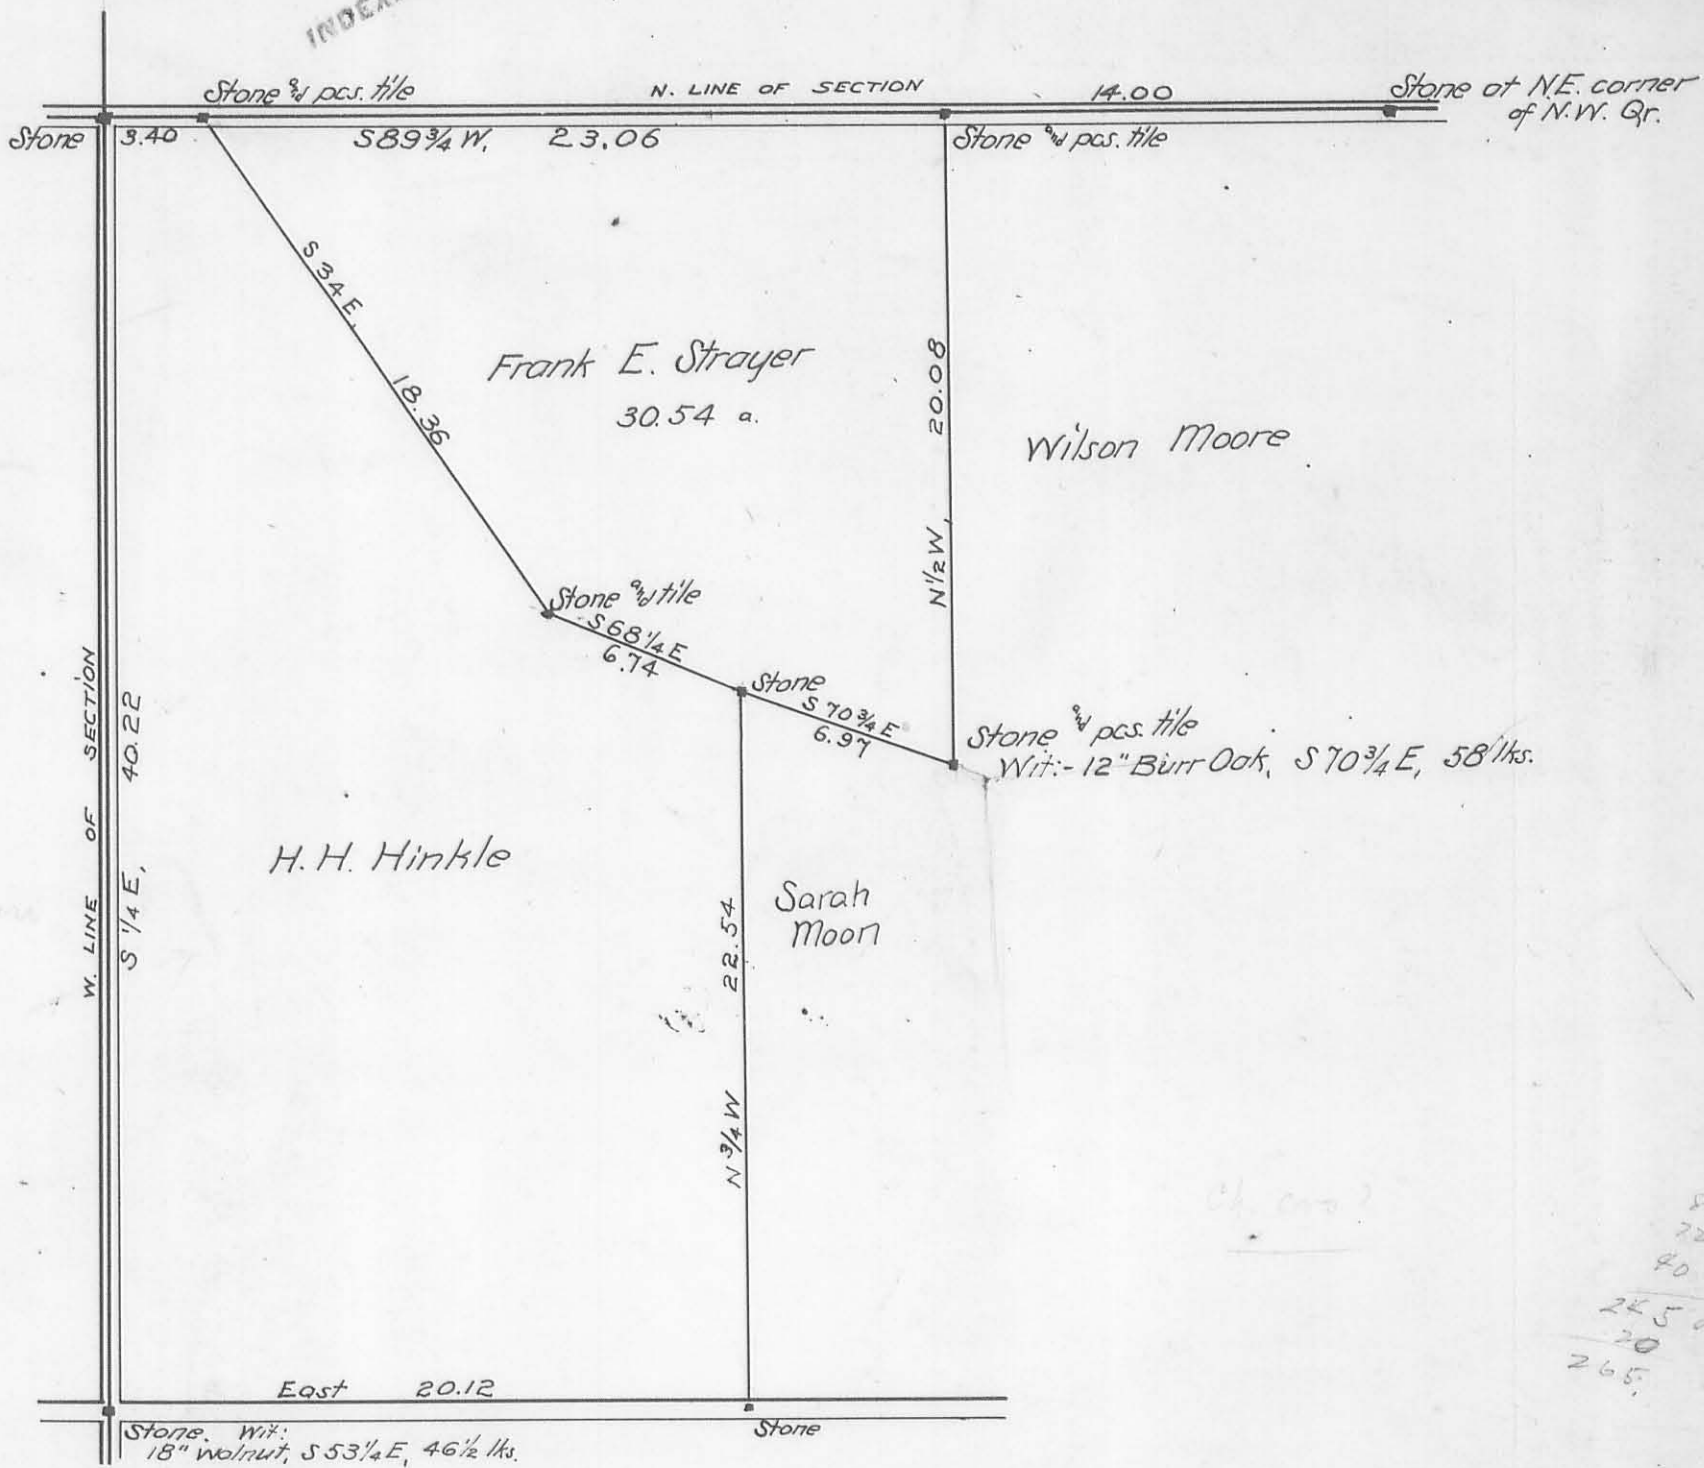

50
 22 25
 80
 72
 40 75
 225 00
 20
 265

H.S. Dailey