


972 IP

INDEXED ON MAP

Norton - McKinnon survey
Pleasant

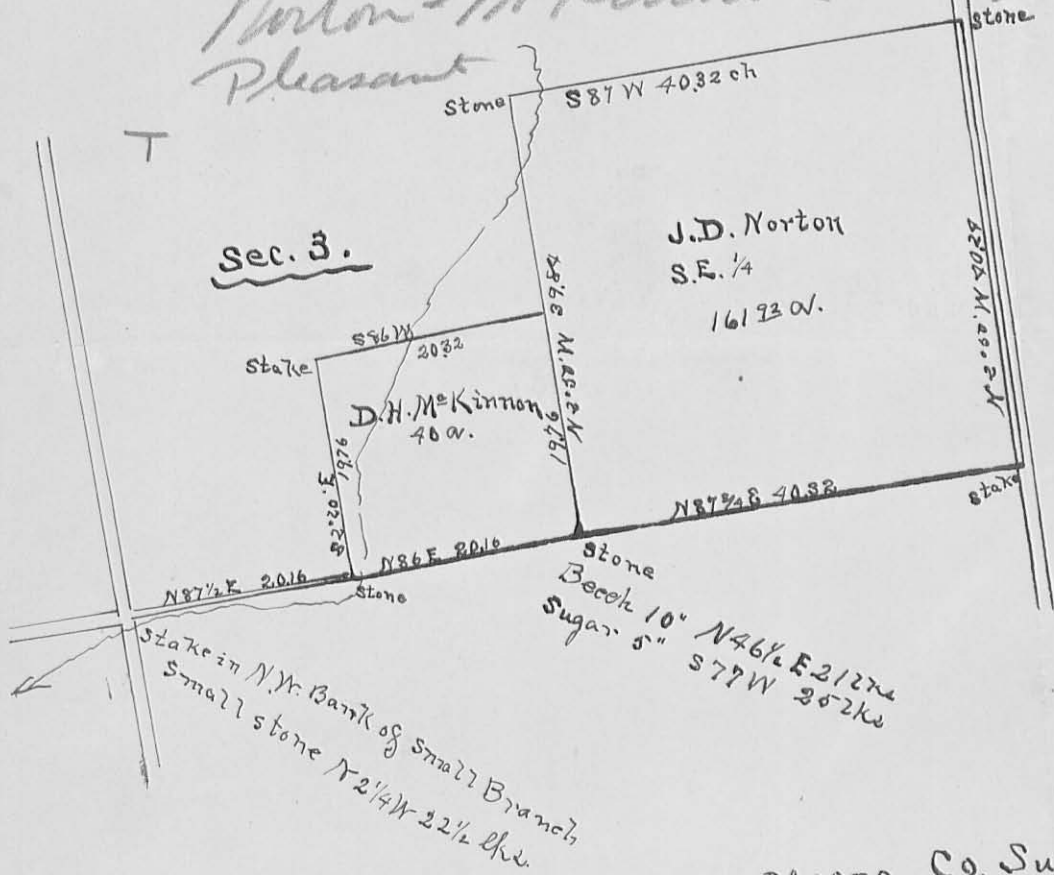

By H. C. Moore Co. Surv. 1863.

See Book "C" Page 66