



Silas Roberts

sec 33 T3 R 14

John C Brown  
106.41

Bertha C. Brown  
20.93

Emma Kibling  
110.60

Elmer M Kibling

27.71  
(Weyant)

Wm H. Hinkle  
40.77

sec. 32 T3 R 14

John L. Makenson  
157.25

W.F.M.

John C. Brown  
60.00

Lewis Huber  
89.00

Daniel  
Huber  
20.71

Georgia A.  
Gurwood  
34.50

M.E. King  
17.00

sec. 27 T3 R 14

Chas. W. Harvey  
81.00

Thos. Z. Stabler  
81.00

H.P. Detrick  
122.00

26+48.5  
stone  
120' left

C.T. Hines  
158.00

S. J. & E. Swank

Geo. C. Huber  
58.36

sec. 26 T3 R 14

J.L. Makenson  
163.22

40.00

Jacob H. Swank

stone 77+79 stone by  
Rickey

church

DeGraff Dike

Road 43

Home Road Survey  
Book 55 Page 45-47  
Road 33

1505 IP

INDEXED ON MAP

This map made  
Oct-1932  
from old notes with  
assistance of M.  
Bailey see Book  
55 Page 45 to 47.  
F.F.M.

File with  
Pleasant Twp.

1505  
INDEXED ON MAP

stones 20' left  
20' Right  
at following  
stations  
(100 Foot  
stations)

- 0+00
- 0+71.7
- 3+70.5
- 6+75.1
- 9+0.4
- 12+3.1
- 14+2.7
- 17+2.7
- 19+6.6
- 22+8.8
- 26+48.5  
Hines by Gale
- 30+6.3 Gale & Weyant
- 35+5.4
- 38+5.9
- 47+8.6
- 53+2.2 stone
- 61+2.9
- 65+9.8
- 70+5.7
- 76+2.1
- 79+7.9

79+80  
old witness  
w.



## Hamer road Surv.

Found a stone with x at  
SE  $\angle$  school lot.

Found stone at SE  $\angle$  Frank  
Hamer. This stone is 20' E  
of Kauffman fence & about  
cent of road to east.

Could not find stone at NW  $\angle$   
Hamer.

Cse bet. these stones as found  
S  $4\frac{1}{2}$  W. = OK.

[S  $20\frac{1}{4}$  W. 34 yrs ago = S  $4\frac{1}{2}$  W today]

Found stone set by Redkey  
at Delmuff pike.

also locate old stone from  
old wit. This came about 5' S.  
& 10" E. of Redkey stone. Old  
stone said to be 5 feet under  
pike. J. S. Makinson over both  
sides of road for 1<sup>st</sup>  $\frac{1}{2}$  mile N  
of pike. My agreement  
w/ Makinson accepts

Feb 23 / 18

wit: as corner, to save digging  
for old stone.

N  $4\frac{1}{2}$  E.

[Wallace Makinson refuses to accept  
this stone set by CWA.]

at Corner Makinson & Hines

found stone lying on side.

Jno Makinson says this stone  
is incorrect, used to stand  
straight up ~~up~~ ~~down~~. Took  
cent of this stone as line.

N  $4\frac{1}{2}$  E

Found stone at NW  $\angle$  Hines

Dr Baker says this stone is not  
where it used to be. [1<sup>st</sup> line  
produced would strike about 5' W.  
of this stone.]

Run between stones at SW  $\angle$  & SE  $\angle$   
Hines, N  $4\frac{1}{2}$  E.

at SE  $\angle$  Dr Baker, cent line  
can 57' W. of stone which Baker  
supposed to be on line.

see note  
page 47

1505  
INDEXED ON MAP



Road 33

Mich 24-110

Run bet. stone at NW  $\times$  Hines  
stone in Sil. Lake Pike at School  
House. N 5 3/4° E

[Note! this stone at school house  
which is generally disputed,  
meas. 131.5' from fence  
at W. line school bet. Sil. Lake  
Pike snow shows 131 feet.  
this meas. made by H.S. without  
any assistance]

1505  
INDEXED ON MAP

46

Start at stone at School  
House.

R.S. on Stone SW  $\times$  Frank Hamer

R. 1° 04' S 5 1/2° W

Meas. S. 100' chain

I. E. Swonger ch. of.

- 0+00 - stone stake 20' E
- 0+21.7 - stake " " W
- 3+20.5 " " 20' E  $\times$  W
- 6+51 " " " "
- 7+93 Tide W, pipe line, just  
N. of Rt-of-way fence
- 8+48 Cent Track Big 4
- 9+04 " line Rt-of-way, stake,  $\vee$  20' E  $\times$  W  
A.R. Detrick E = E.M. Kiblinger W
- 12+31 stake, State 20' E = W
- 14+36 Entrance to R.S. E
- 14+27 stake 20' E  $\times$  W
- 17+27 stake 20' E  $\times$  W
- 19+64 " " "
- 22+88 " " "

see note Page 47

# Road D

47

- 26+48S Stone, & Hines<sup>an</sup> & Galer.  
Stakes 20' E x W  
L. 10° 0" SA 1/2' W
- 50+68 Galer<sup>an</sup> & Wilson Weyand W.  
Stake 0 x 20' E x W
- 55+54 At N. line Hines' yard  
Stake 0 x 20' E x W
- 38+59 Weyand & Makemson W.  
Stake 0 x 20' E x W
- 47+86 Stakes 20' E x W
- 53+~~22~~ Stone & Hines<sup>an</sup> & Makemson  
Stakes 20' W x E  
L. 0° 06'
- 61+29 Stake 0 x 20' E x W
- 65+98 " " "
- 70+57 { " " "  
at N. side Makemson Orchard
- 76+21 Stake 0 x 20' E x W
- 79+79 Stone set by CMP at DeG-pite
- 79+88 Location of old stone as per  
old writ: -

Z. E. Swonger de cr 1 1/2 da  
Walter Nangle 1/2 da

Map made Oct-1933  
By Wright.  
Using 1910 Plat  
Book for names  
see map drawer  
R (1505)  
Pleasant Tap.

(1505)  
INDEXED ON MAP



Road No. 33  
Pleasant Twp

40' Road

stakes placed Sta.  
48 - 50 - 52 - 54 etc.  
20' from  $\phi$

See Survey (1030) Union Twp.

(1505)  
INDEXED ON MAP

Nov. 29, 1933  
Windy  
Warm  
Wright  
Ed. Cox


48

Concrete  
Bdry

Sec 25-3-14

Sec 31-3-14

Degraff Pike  
Road No.

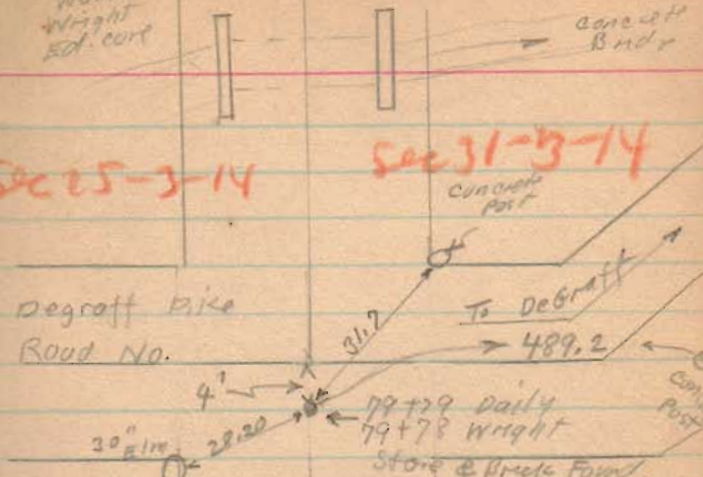

UNION  
TWP.

PLEASANT  
TWP.

Sec. 26 T. 3 R. 14

Sec 32-3-14

