

Road 211
Pleasant & Washington TWPs.

32' Road Road Record Vol. 3 PP 214-229

Map - Road Record Vol. 3 - Page - 222

1901.

staked, 32'


sta. 22-24-26-28-30 etc.

1657

INDEXED ON MAP


May-14-1935
cloudy-cool
E. Wright
E. Co. Ave.
Wagner

Joseph Kaylor

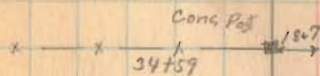


J. W. Bartleson

Howard S. Kaylor

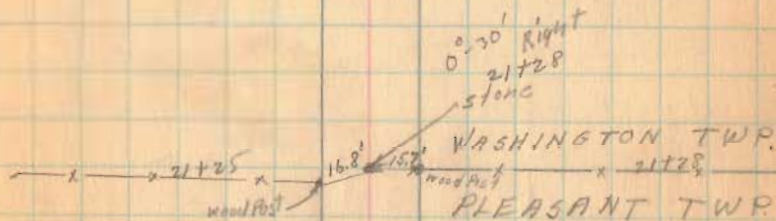

Phoebe A. Martin

Bellefontaine Bldg.
& Loan Co.

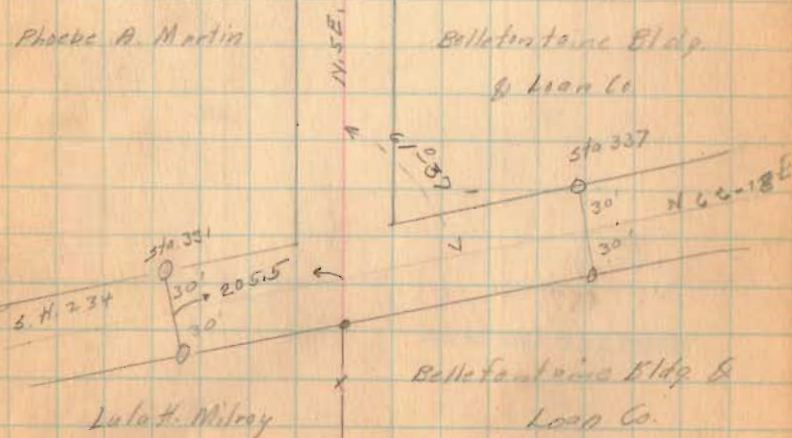

Road 211

5-14-35

48

Joseph Kaylor

62+97

Drive

Joseph Kaylor

Howard S. Kaylor

Drive

47+84

Found Broken tile
Placed Iron Pin
0-15' left

Sec. 5-T2-R14

Conc.
Post

x x x

Sec. 4-T2-R14

steel
post

Sec. 35-T3-R14


Sec. 34-T3-R14

Joseph Kaylor

Howard S. Kaylor

1657

INDEXED ON MAP

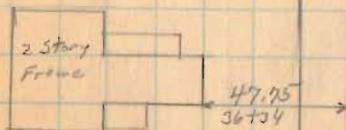

Road 211

Road 207

1657

INDEXED ON MAP

5-14-25

29

