

Smith - Ammon Survey Pleasant Township September 1962 1.25 Acres

The following described land in Pleasant Township, Logan County Ohio and being in S.E. Quarter of Section 33 Town 2 Range 8.

Beginning at a stone at the N.E. corner of the S.E. Quarter of Section 33 Town 2 Range 8 and also being the S.E. corner of Warren Smith's 101.00 acre tract and also being in the south line of Bloomfield Township and in the North line of Pleasant Township.

Thence with the east line of said Section 33 S. 1 - 00 E. 499.50 feet to an iron, said iron being the beginning point of this survey.

Thence again with the east line of said section 33 again S. 1 - 00 E. 179.40 feet to an iron at the S.E. corner of Wilbur C Ammon's present 20.25 acre tract. The last described line being approximately 19.00 feet west of and parallel with the center line of County Road Number 34.

Thence with the south line of said Ammon's present 20.25 acre tract and with the north line of a 20.00 acre tract S. 88 - 25 W. 302.60 feet to an iron.

Thence N. 1 - 00 W. 182.50 feet to an iron. .

Thence N. 89 - 00 E. 302.60 feet to the place of beginning.



The above described contains 1.25 acres and is out of the S.E. corner of a 20.25 acre tract now in the name of Wilbur C. Ammons.

cc
Logan County Engineer.



3437 ID

INDEXED ON MAP

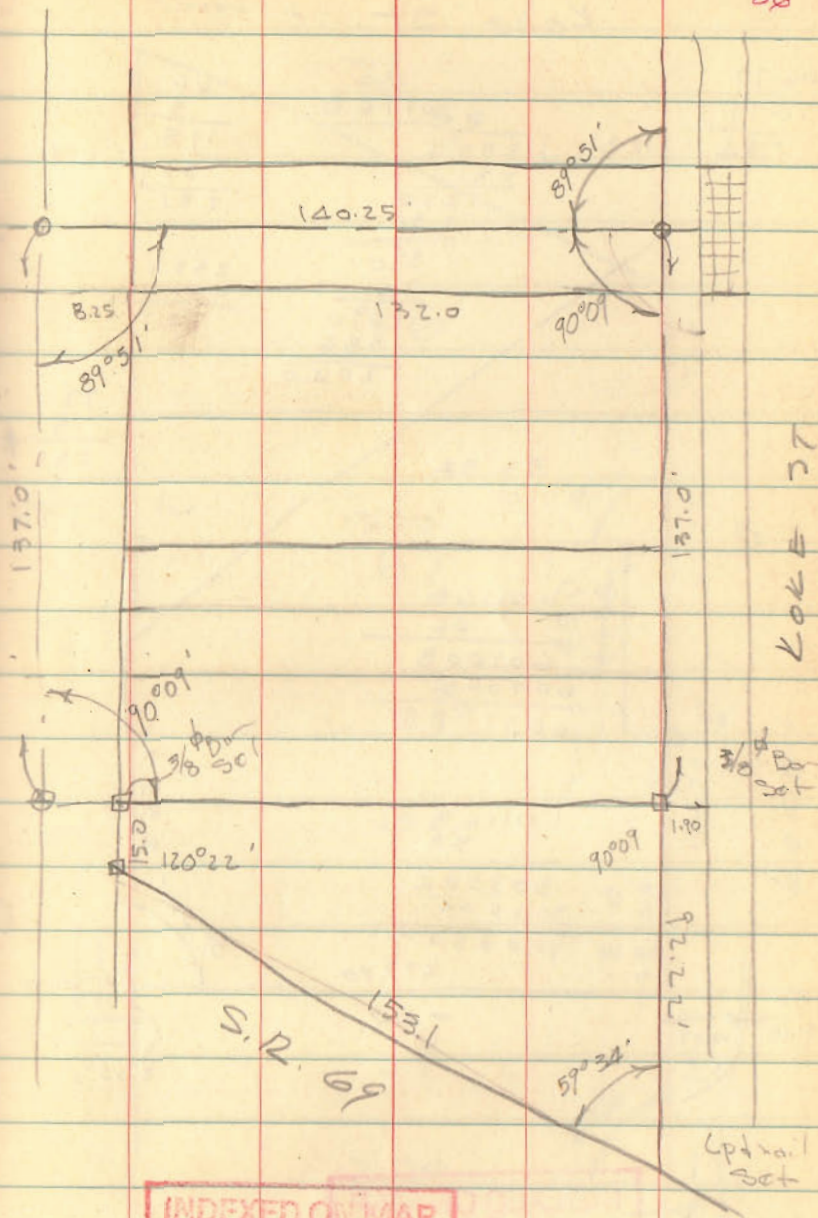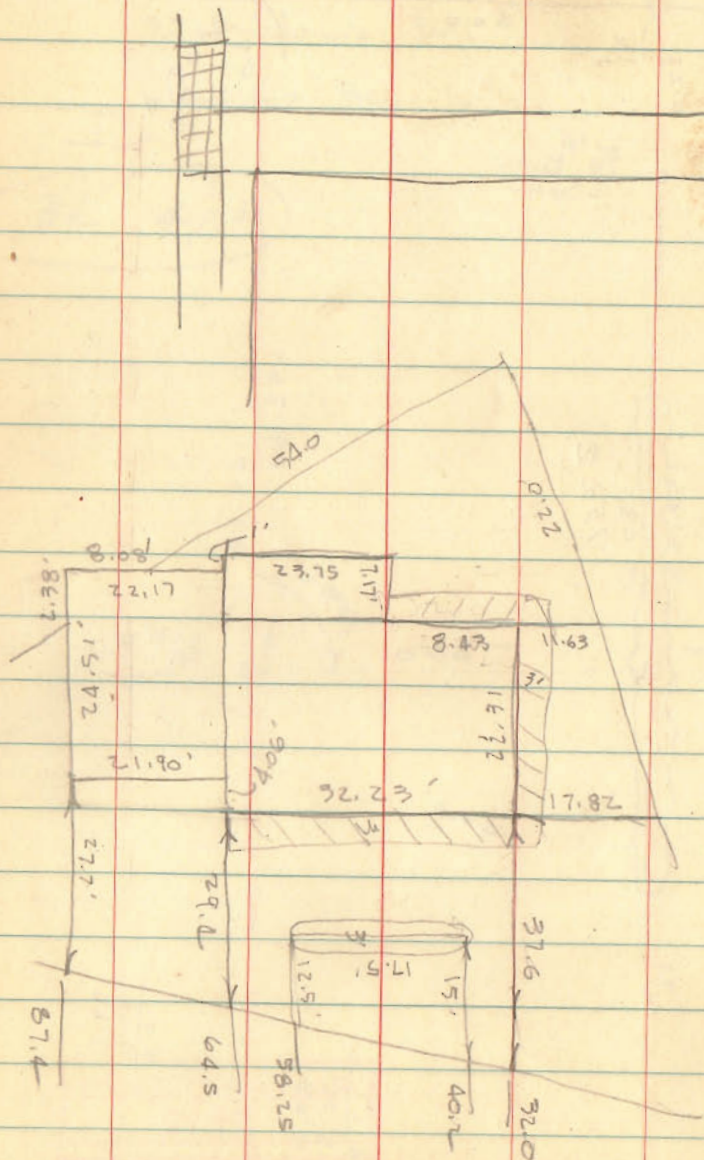

INDEXED ON MAP
3437