


REC'D 6-26-96 SKY SCALE: 1" = 60'

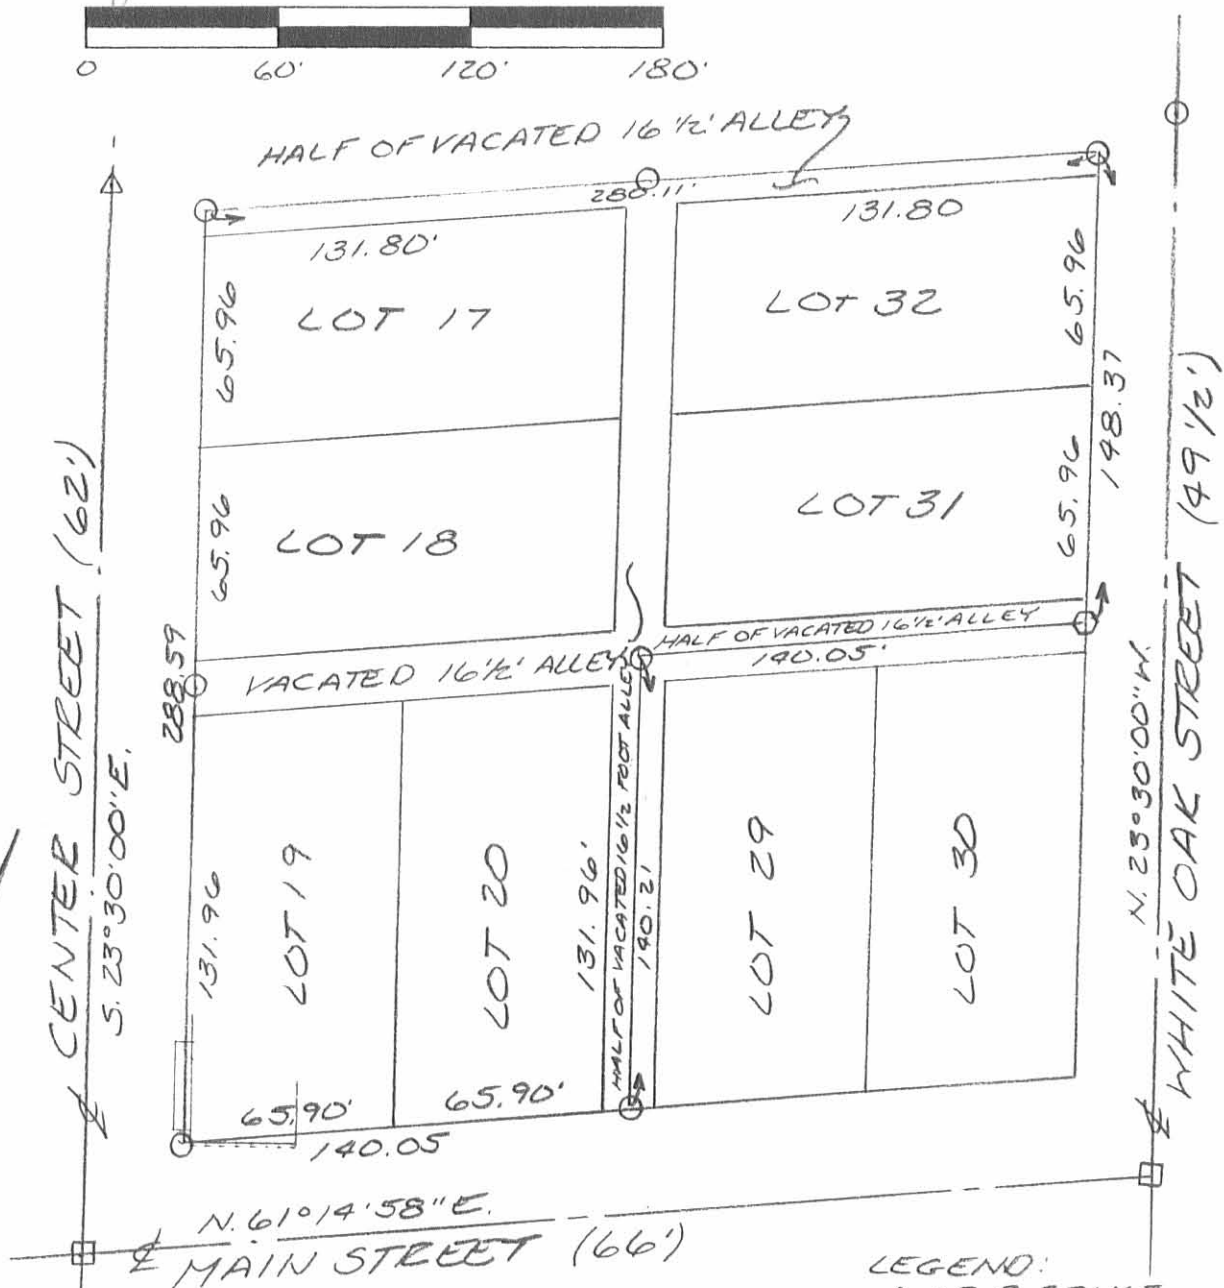

- LEGEND:
- △ = R.P. SPIKE FOUND
 - = 1 INCH SQUARE IRON BAR FOUND
 - = 5/8 INCH IRON BAR SET
 - ◇ = CAP AND NAIL SET

SURVEY OF LOTS 17, 18, 19, 20, 31, AND 32 OF THE VILLAGE OF LOGANVILLE, SECTION 15, TOWN 2, RANGE 14, PLEASANT TOWNSHIP, LOGAN COUNTY, OHIO FOR JOE STRASSER ON JUNE 26, 1996



Leslie H. Geeslin
 LESLIE H. GEESLIN
 RUSHSVLVANIA, O
 (513) 468-2793

INDEXED ON MAP
 9080 IP