


Belle Center Race Track Aug. 1/13  
 On Mrs M'Loira Farm S.E. of B.C.

(751)

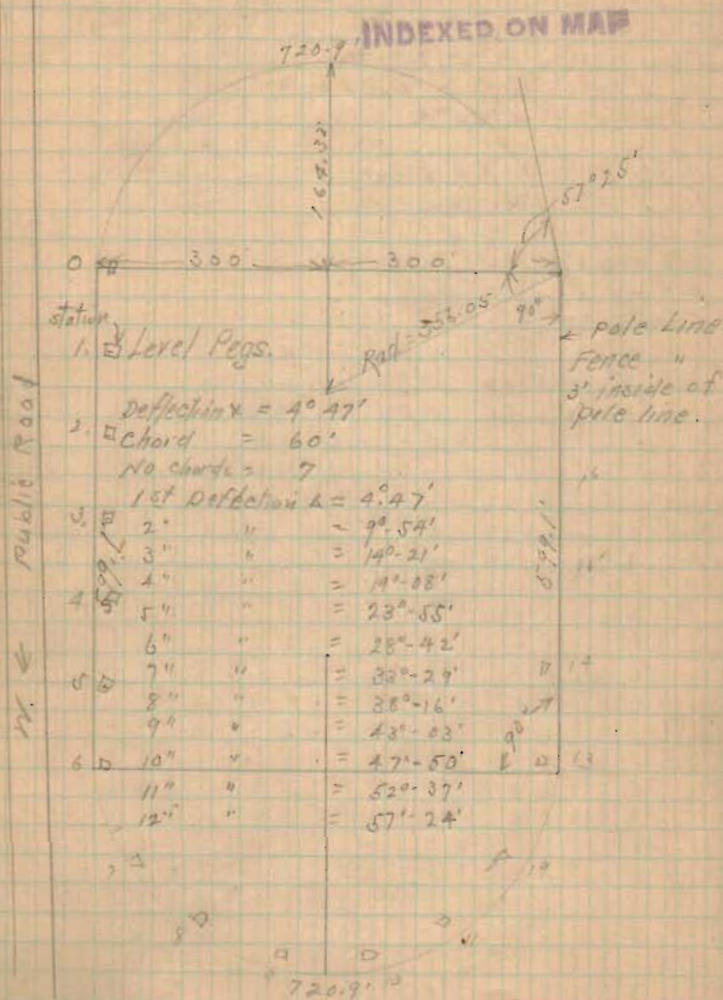

Levels Race Track 9/12/13

B.M.	57.2	40.00	Pegs	Fill	
T	45.72		Cut		
0"		75.8	38.14	39.10	.96
1"		97.8	36.04		
B		97.0	36.02		
C		99.4	35.78		
1"		6.36	39.36	39.42	.06
A		8.24	37.48		
B		8.92	36.90		
C		7.74	37.98		
2"		3.06	42.66	39.74	2.92
A		4.65	41.07		
B		6.25	39.47		
C		6.95	38.77		
3"		2.58	43.14	40.06	3.08
A		4.55	41.17		
B		6.05	38.67		
C		6.60	39.12		
4"		0.36	45.36	40.38	4.98
A		3.20	42.52		
B		5.00	40.72		
C		5.30	40.42		
5"		1.10	44.62	40.70	3.92
A		3.15	42.57		
B		4.75	40.97		
C		5.10	40.62		
6"		1.04	44.68	41.02	3.66
A		3.05	42.87		
B		4.45	41.27		
C		4.80	40.92		
G.T.P.	11.02				
T	55.70				
7"		9.34	46.36	42.14	4.22
A		11.20	44.50		
B		12.20	43.50		
C		12.10	43.60		
8"		9.04	46.66	43.26	3.40
A		10.86	44.84		
B		12.10	43.60		
C		12.50	43.20		

T	61.19			C	F
17"		8.27	52.92	50.10	2.82
A		10.60	50.59		
B		10.90	50.29		
C		10.90	50.29		
18"		11.83	49.36	49.10	.26
18TP	1.59				F <sup>200</sup>
T	<u>56.95</u>				
A		3.40	47.55		
A'		2.30	48.65		
B		1.80	49.15		
C		1.50	49.45		
19"		3.57	47.38	47.10	.28
A		6.30	44.65		
A'		3.75	47.20		
B		5.30	45.65		
C		2.70	48.25		
20"		6.16	44.79	45.10	.31
A		8.10	42.85		
A'		6.35	44.60		
B		5.80	45.15		
C		4.85	46.10		
21"		6.90	44.05	44.10	.05
A		8.75	42.20		
B		8.60	42.35		
C		8.60	42.35		
22"		7.50	43.45	43.10	.35
A		10.20	40.75		
B		10.80	40.15		
C		10.75	40.20		
23"		10.38	40.57	42.10	1.53
A		12.00	38.95		
24"		10.31	40.64	41.10	.46
A		12.35	38.60		
25"		11.64	39.81	40.10	.79
A		13.65	37.30		
26 to 4				39.10	.96
20"		12.84	38.11		

e. s = level

" = "