


Road. 39 Richland Twp.

50' { Huntsville - Bellecenter Pike
Record filed with Road. 39
Pike plat Brk 90x 57

1380

INDEXED ON MAP

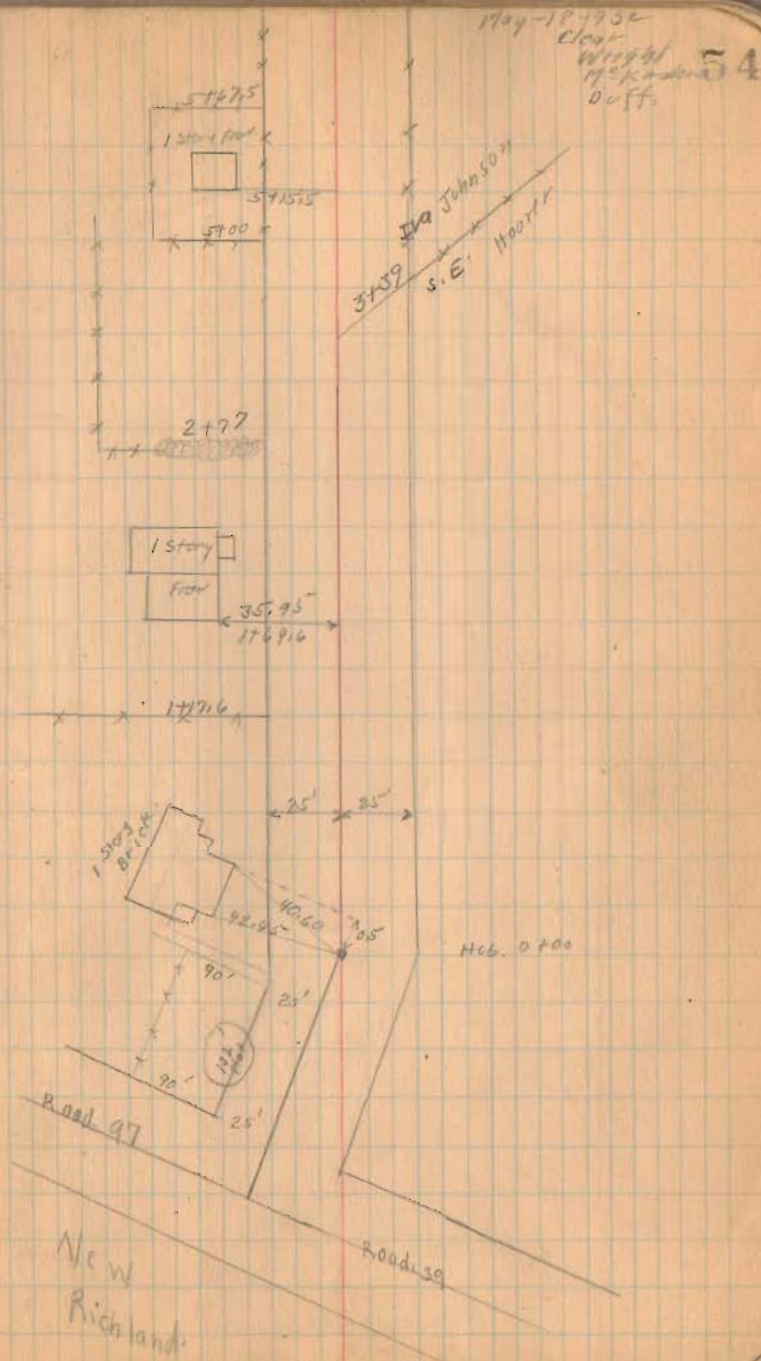


Road. 39

1380

INDEXED ON MAP

5/18/32

55

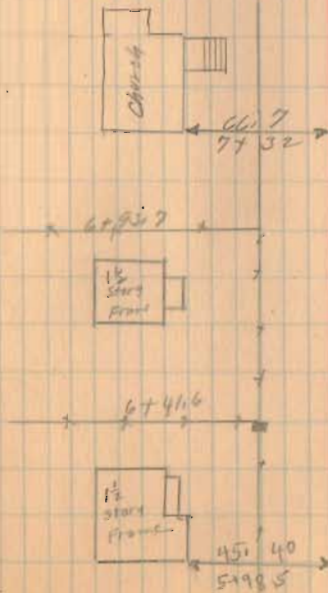

Road. 39

See Page 66 for Road 39
Near Bellecenter.

See Book 579

1380

INDEXED ON MAP

J.C. Patton

Road 49
(See Page 25)

R.G. Milligan

5/1/52

56

W. W. Fry

31 + 65.45
R.R. Spite

F.T. Road.

Bridge No 39-5.85

