

FB 701

Survey of Shady Lane
Fernwood # 3


For Richland Twp. Trustees

- A = 3/4" ϕ Iron found
- B = 1/2" pipe found - bent
- C = 3/4" pipe found
- D = 1/2" Pipe found 1.3 N.E. of garage (garage on S. side of the)
- E = 3/4" Pipe found
- F = 1" Pipe found - 12" \pm deep
- G = 1" pipe found

See Plan ~~J-116~~ J-116 for Fernwood # 125

D. Dodson
v. Detrick
9/26/57

53

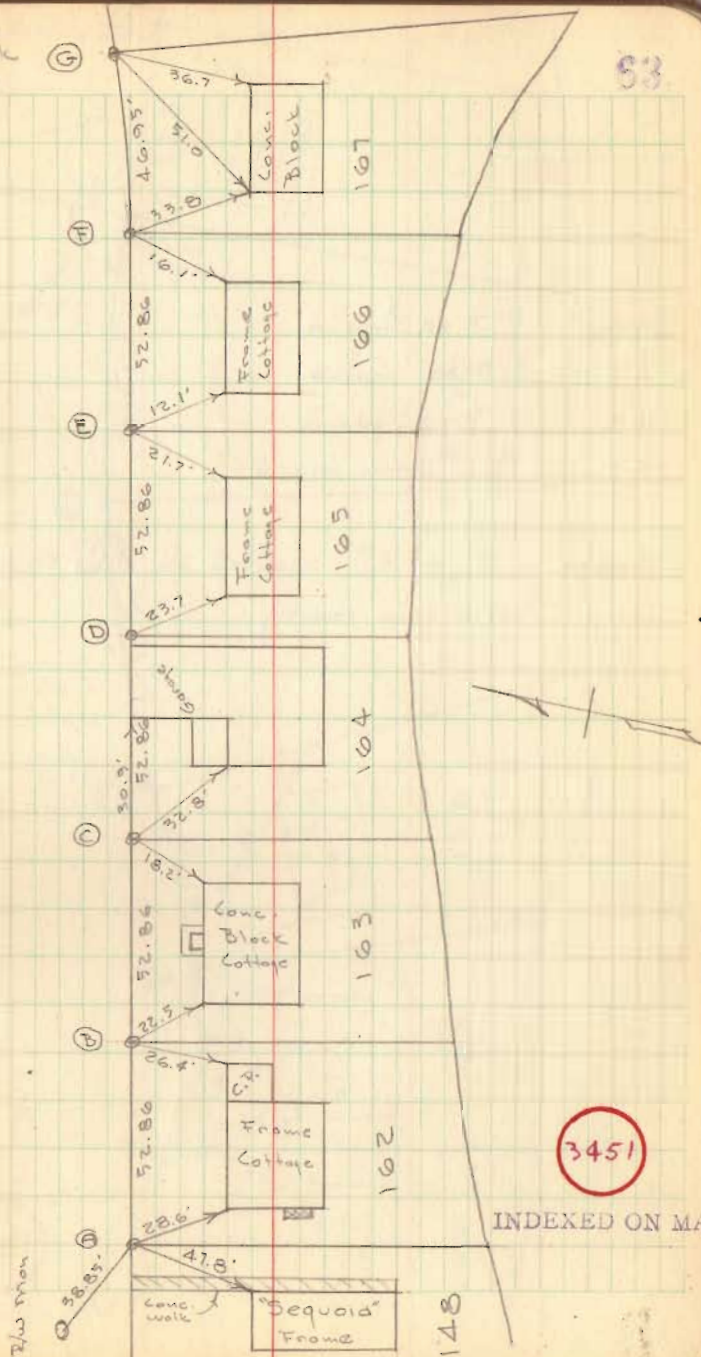


3451

INDEXED ON MAP

Shady Lane Cont'd

- H = 1" Pipe found
- I = 1" Pipe found
- J = 1" Pipe found
- K = 1/2" ϕ Iron found

Note. X at \odot sighted on R/w Man's,
both line exactly

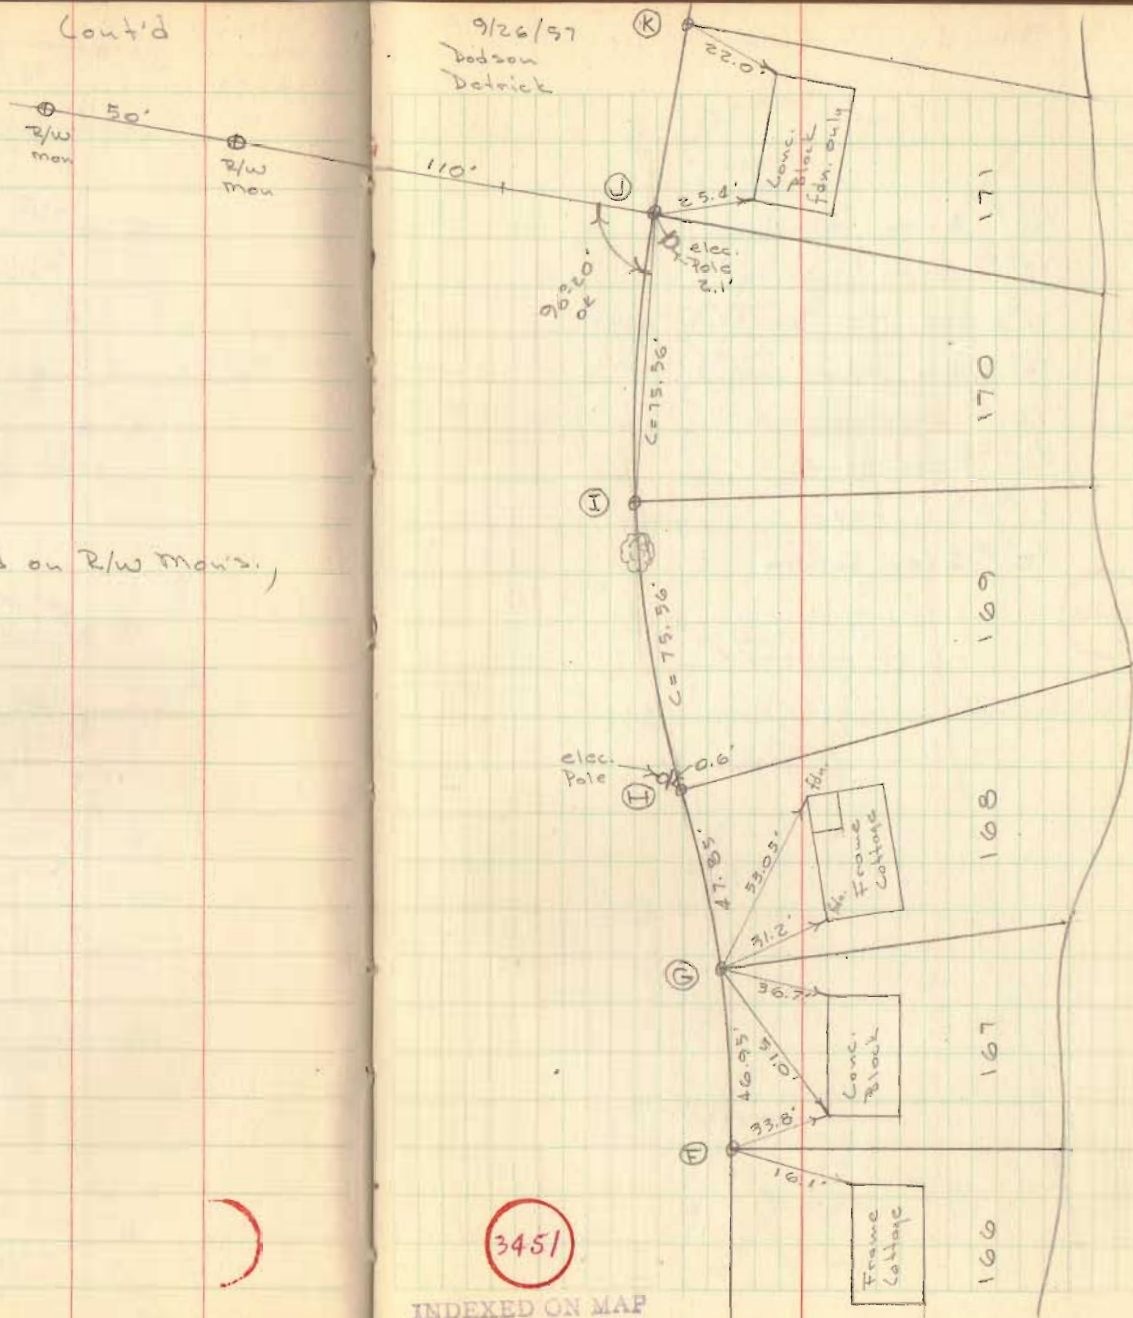

3451

INDEXED ON MAP


FB 701

Shady lane Cont'd

- L = 1/2" ϕ Iron found
- M = 1/2" ϕ Iron found
- N = Did not dig for this one
- P = 1/2" pipe found
- Q = 1/2" ϕ Iron found
- R = 1/2" Pipe found
- S = 1" Pipe found
- T = 1/2" ϕ Iron found

9/26/57
Dadson
Detrick

65

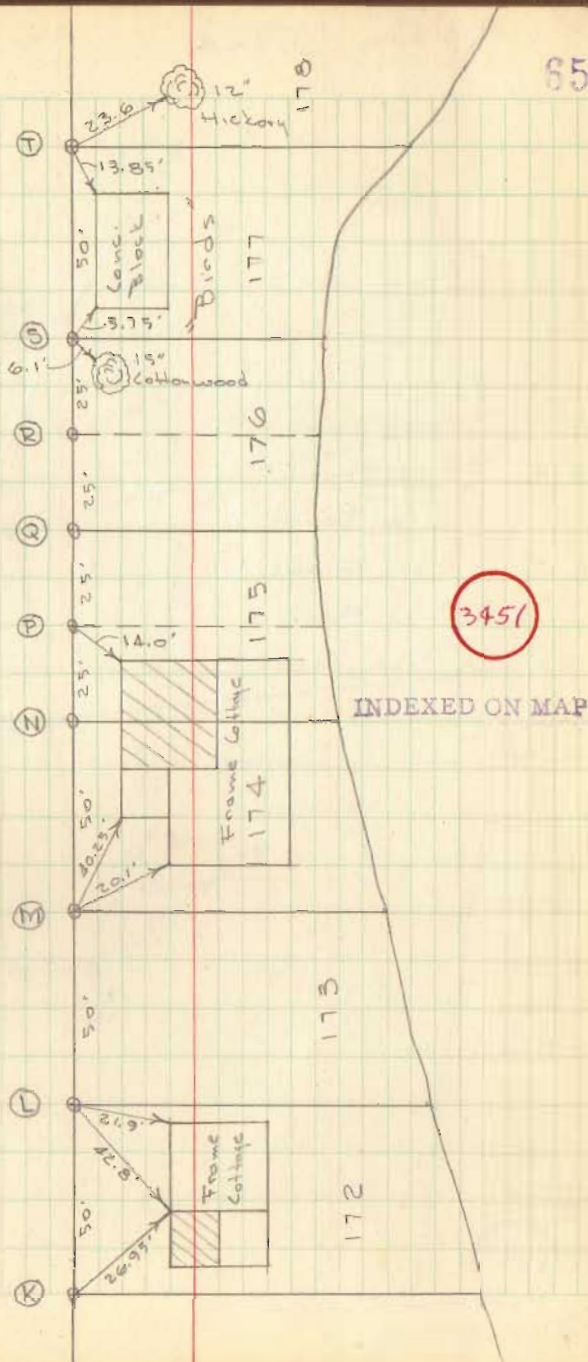

Shady Lane Cont'd


FB 701

- U = 1" Pipe Found
- V = 1" Pipe Found
- W = 1" Pipe Found
- X = 1" Pipe Found
- Y = 1" Pipe Found
- Z = 3/4" Pipe Found



Padron
Detrick 9/26/57

66

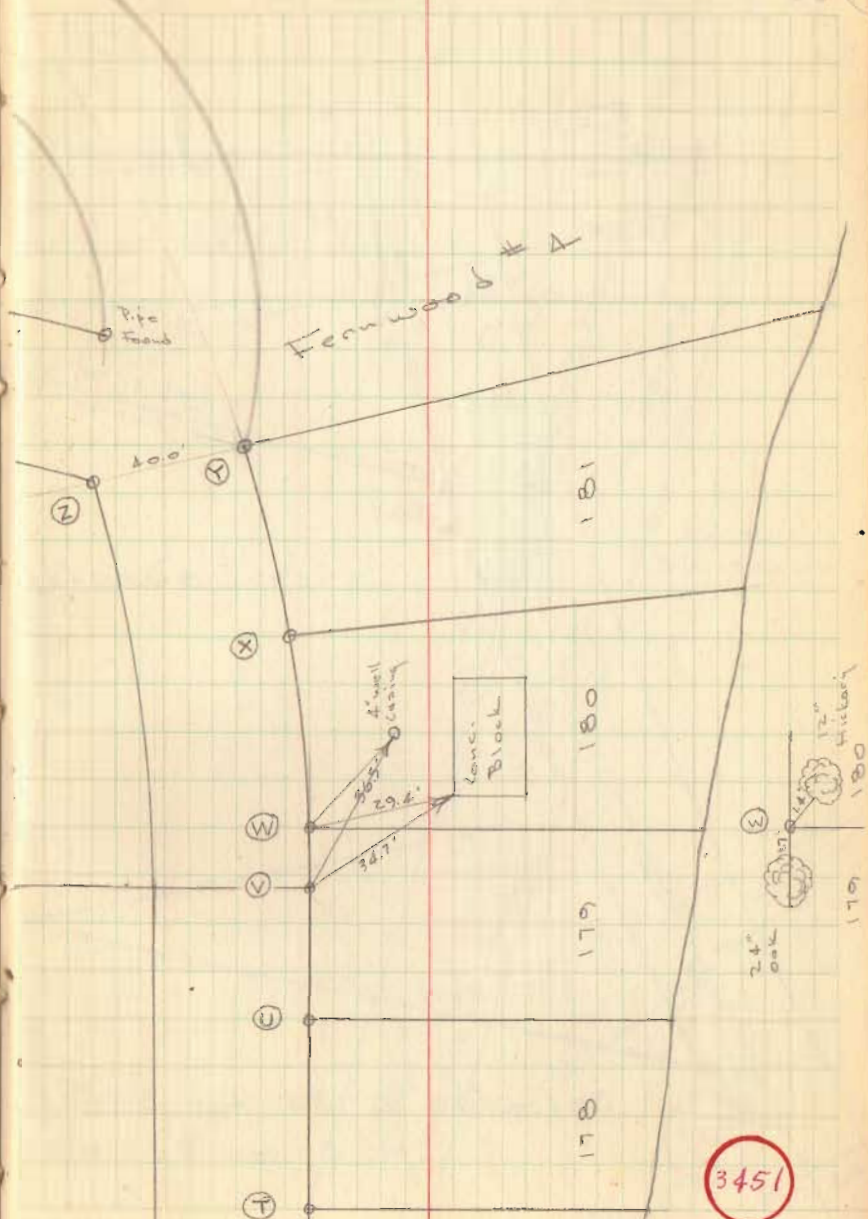

3451

INDEXED ON MAP