


8517

Sunny
074535

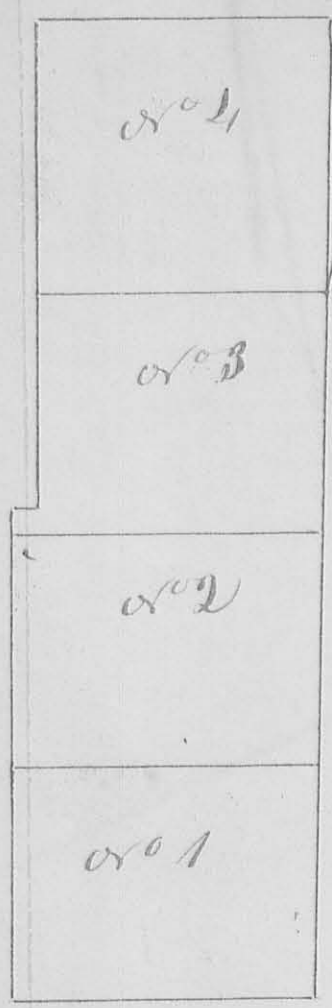

Surveyed and subdivided
 June 18th 1865 for Jacob Fry
 part of survey no 9968 as
 follows. Lot no 1 Beginning
 at 2 Small Buck Eyes & a sugar
 and run S 78 W 125 poles to an
 oak & 2 small Elms (all gone)
 then N 12 W 95.4 poles to stone
 in edge of Meyers line then N 78
 E 127.75 poles to a stone and 2
 Maples in the East patent line
 then S 12 E 95.4 poles to the Beginning
 containing 76 ¹²/₁₀₀ Acres

Lot no 2, Beginning at a
 stone and 2 Maples in the East
 patent line an run S 78 W
 127.75 poles to S W corner of

Lot no 1 then N 12 W 94.5 poles to a stone in
 edge of Meyers line then N 78 E 95 poles to a stone
 in said line then N 78 E 128.5 poles to a stone in
 East patent line then with said line S 78 E 95
 poles to the Beginning containing 76 ¹²/₁₀₀ Acres

Lot no 3, Beginning at a stone in E corner to Lot no 2
 & run S 78 W 128.5 poles to stone corner to Lot no 2 then
 N 12 W 115 poles to water Buck & maple then N 78 E 10
 poles to 3 small sugars (2 gone) corner to edge of Meyers then
 N 12 E 90 to stone in edge of Meyers line then N 78 E 121
 poles to stone in East patent line then with said line
 S 12 E 102 poles to Beginning containing 76 ¹²/₁₀₀ Acres

Lot no 4, Beginning at S Buck in E patent corner & run S
 12 E 113 poles then S 78 W 121 poles to stone then N 12 W 113
 poles to edge of Meyers corner in E patent line then N
 78 E 123 poles to the Beginning containing 86 ¹²/₁₀₀ Acres

This report ought to have preceded C. S. & Co
 the last one