## LESLIE H. GEESLIN

REGISTERED SURVEYOR NO 5248

P O. BOX 274

## RUSHSYLVANIA, OHIO 43347

TELEPHONE: (513) 468-2793

BALES SURVEY May 20, 1993

The following described real estate situated in the State of Ohio, Counties of Hardin and Logan, Townships of McDonald and Richland, being part of Virginia Military Survey 9989 and more particularly described as follows:

Beginning at a cap and nail set in the centerline of Hardin County Highway 75 at the southeast corner of Mary B. Goff's 29.84 acre tract as described in D. B. Vol. 104 Page 244.

Thence with said centerline SOUTH 231.00 feet to a cap and nail set in the centerline of Logan County Highway 106, passing a 5/8 inch iron bar found in the county line at 191.00 feet, said cap and nail being at a north corner of Phillip Lautenschlager's 92 acre tract as described in D. B. Vol. 383 Page 149.

Thence with said Lautenschlager's north line S. 89° 18' 43" W. 379.50 feet to a 5/8 inch iron bar set.

Thence with said Lautenschlager's east line NORTH 231.00 f eet to a 5/8 inch iron bar set in the south line of said Goff.

Thence with said Goff's south line N. 89° 18' 43" E. 379.50 feet to the place of beginning.


Containing 2.012 acres more or less, of which 1.312 acres are in Hardin County and 0.700 acre is in Logan County of which 0.026 acre is in the right-of-way of Logan County Highway 106.

The above described survey being a new survey of a 2 acre tract as described in Logan County O. R. Vol. 107 Page 678 and Hardin County D. B. Vol. 112 Page 221.

Bearings are based on an assumed bearing (SOUTH) for the centerline of C. H. 106 and 75 in this field survey by Lesie H. Geeslin.



Leslis A Jershin

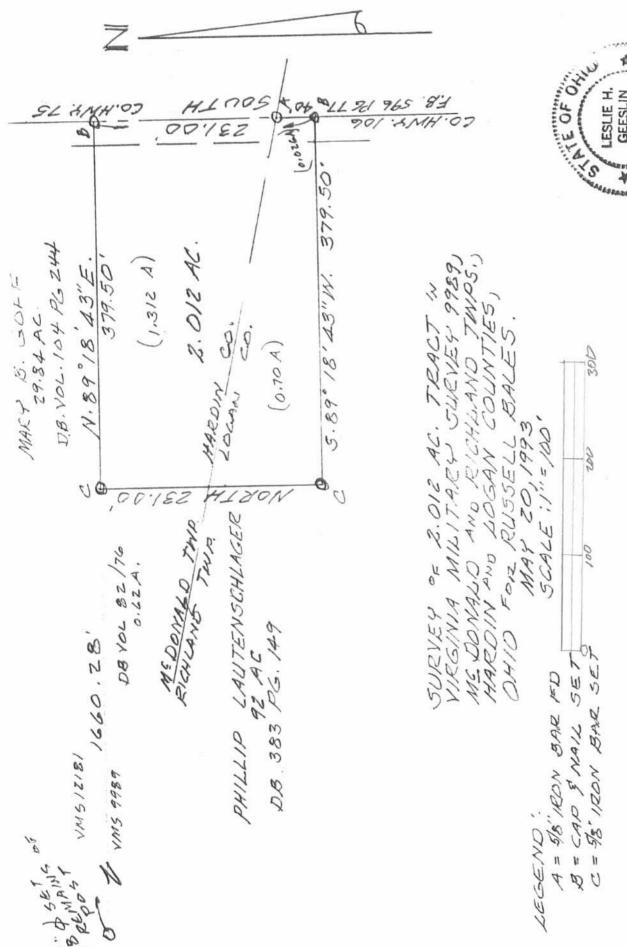

LESLIE H. GEESLIN ASSURVEYOR

1AP & Elin A HISA hor 1ESLIE H. GEESL, 12USHSYLYANIA, ON 12USHSYLYANIA, ON

INDEXED ON MAP