


LEGEND:

- = 5/8" IRON BAR FOUND
- = 5/8" IRON BAR SET

SURVEY OF LOT 127 OF VILLAGE OF RIDGEWAY, BOKESCREEK TWP., LOGAN COUNTY, OHIO FOR OLIVE RAMSEY.

JANUARY 14, 1998  
SCALE: 1" = 30'

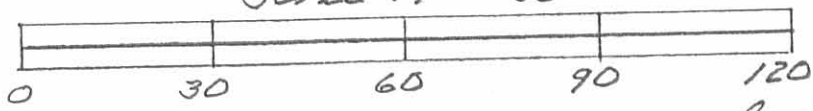

*Leslie H. Geeslin*  
LESLIE H. GEESLIN  
RUSHSVLVANIA, OH

7965 IP

Received 11-13-89 OK 11-15-89

SURVEY OF LOT 126 IN RIDGEWAY FOR IVAN DICK  
TRACT 1  
NOVEMBER 11, 1989

The following described tract is situated in the State of Ohio, County of Logan, Township of Bokescreek, Village of Ridgeway and is part of Virginia Military Survey No. 10239. Said tract is also part of Ivan Dick's Lot 126 as recorded in Official Records Volume 91, Page 251. Said lot being part of the original plat of Ridgeway as recorded Cabinet A, Slide 155 and is more fully described as follows:

Commencing at a 5/8 inch diameter iron bar set at the northeast corner of Lot 126, said bar being in the south line of Buck Street and the west line of Main Street;

Thence North-89°-43'-28"-West (this bearing is the basis of bearing and is assumed, all other bearings are from angles and distances measured in this field survey) 112.22 feet with south line of Buck Street to a 5/8 inch diameter iron bar set, said bar being the point of beginning of this description;

Thence South-0°-16'-30"-West 66.00 feet to a 5/8 inch diameter iron bar set in the north line of Hobart M. Ramsey's Lot 127 as described in Deed Book Volume 348, Page 952;

Thence North-89°-43'-27"-West 54.16 feet with the north line of Lot 127 to a 5/8 inch diameter iron bar set in the east line of an alley;

Thence North-0°-13'-07"-East 66.00 feet with the east line of said alley to a 5/8 inch diameter iron bar set in the south line of Buck Street;

Thence South-89°-43'-28"-East 54.22 feet with the south line of Buck Street to the place of beginning.

Said description is based on a field survey performed on November 11, 1989. Lot 126 is also known as Permanent Parcel No. 06-027-05-05-007.

INDEXED ON MAP  
7965 2D-1



*Leslie H. Gesslin*  
LESLIE H. GESSLIN  
PENNSYLVANIA, OHIO

SURVEY OF LOT 126 IN RIDGEWAY FOR IVAN DICK  
TRACT 2  
NOVEMBER 11, 1989

The following described tract is situated in the State of Ohio, County of Logan, Township of Bokescreek, Village of Ridgeway and is part of Virginia Military Survey No. 10239. Said tract is also part of Ivan Dick's Lot 126 as described in Official Records Volume 91, Page 251. Said lot being part of the original plat of of Ridgeway as recorded in Cabinet A, Slide 155 is more fully described as follows;

Begining at a 5/8 inch diameter iron bar set at the northeast corner of Lot 126, said bar being on the south line of Buck Street and the west line of Main Street;

Thence South-0<sup>0</sup>-19'-54"-West (this bearing is the basis of bearing and is assumed, all other bearings are from angles and distances measured in this field survey) 66.00 feet with the west line of Main Street to a 5/8 inch diameter iron bar set at the northeast corner of Hobart M. Ramsey's Lot 127 as described in Deed Book Volume 348, Page 952;

Thence North-89<sup>0</sup>-43'-27"-West 112.16 feet with the north line of Lot 127 to a 5/8 inch diameter iron bar set;

Thence North-0<sup>0</sup>-16'-30"-East 66.00 feet to a 5/8 inch diameter iron bar set in the south line of Buck Street;


Thence South-89<sup>0</sup>-43'-28"-East 112.22 feet with the south line of Buck Street to the place of beginning.

Said description is based upon a field survey performed on November 11, 1989. Lot 126 is also known as Permanent Parcel No. 06-027-05-05-007.

INDEXED ON MAP  
7965202



*Leslie H. Gesslin*  
LESLIE H. GESSLIN  
PUNXSUTLVANIA, OHIO

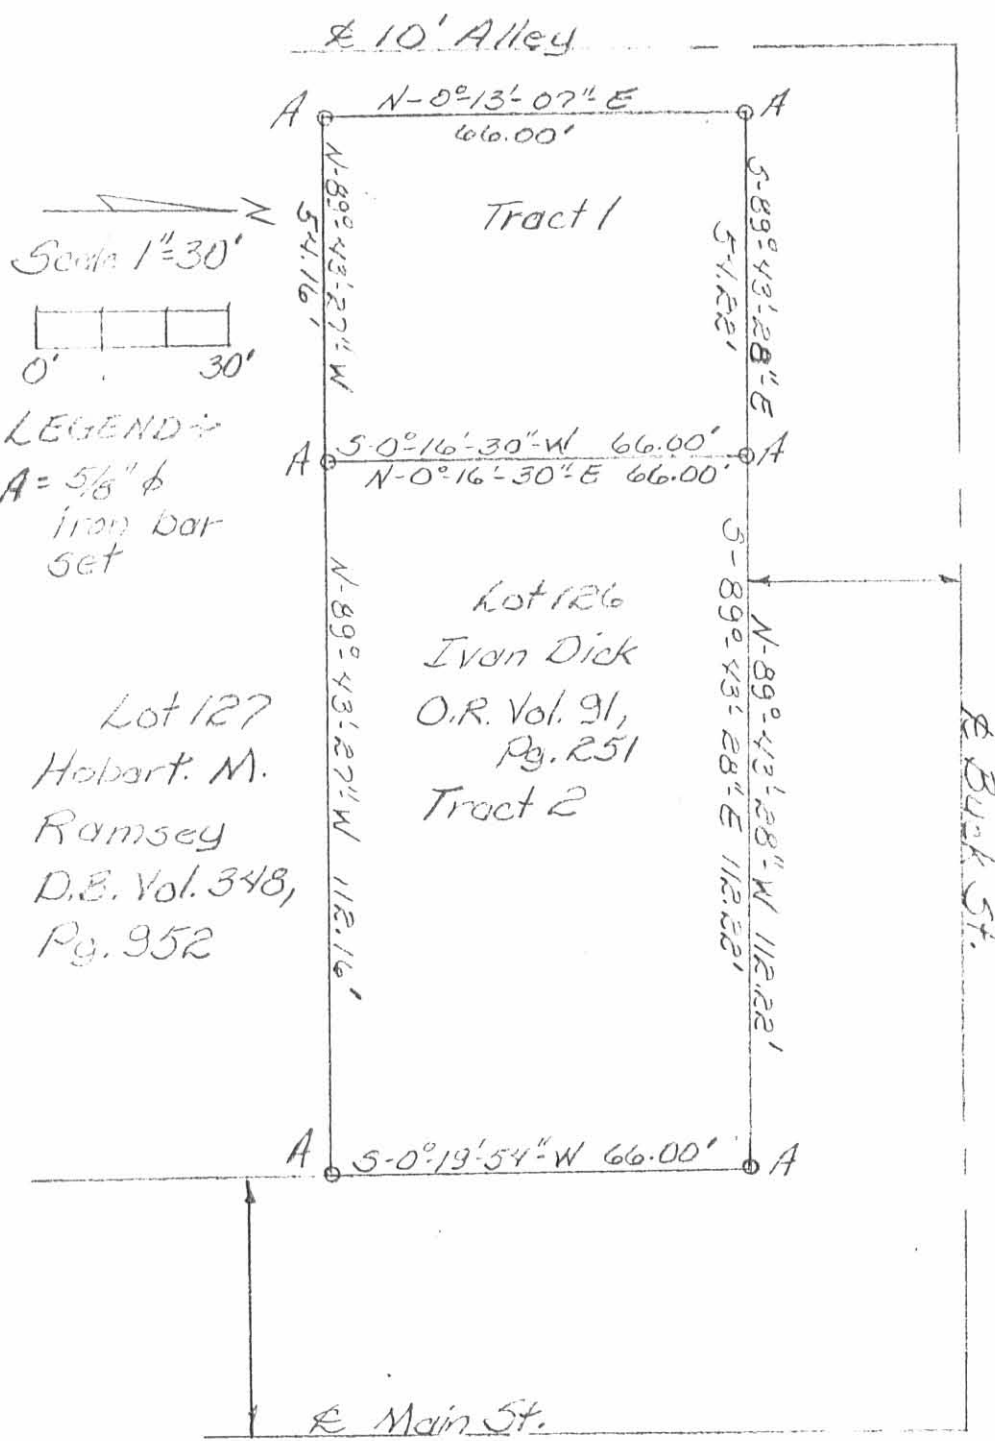

Reference:  
Original Plat  
of Ridgeway,  
Cabinet A,  
Slide 155

Scale: 1"=30'  
0' 30'  
LEGEND:  
A = 5/8" iron bar set  
Lot 127  
Hobart M.  
Ramsey  
D.B. Vol. 348,  
Pg. 952

Lot 126  
Ivan Dick  
O.R. Vol. 91,  
Pg. 251  
Tract 2

Survey of Lot 126  
for Ivan Dick  
Village of Ridgeway,  
V.M.S. 10239, Bakescreek  
Twp., Logan Co., Ohio  
November 11, 1989

INDEXED ON MAP  
796.5 2P



*Leslie H. Gesslin*  
LESLIE H. GESSLIN  
RUSHSVLVANIA, OHIO

By JKC