

Compared

— Plat —


Sarah E. Knepper Surv.

in Surv. 10041

May 14, 07

(156)

INDEXED ON MAP

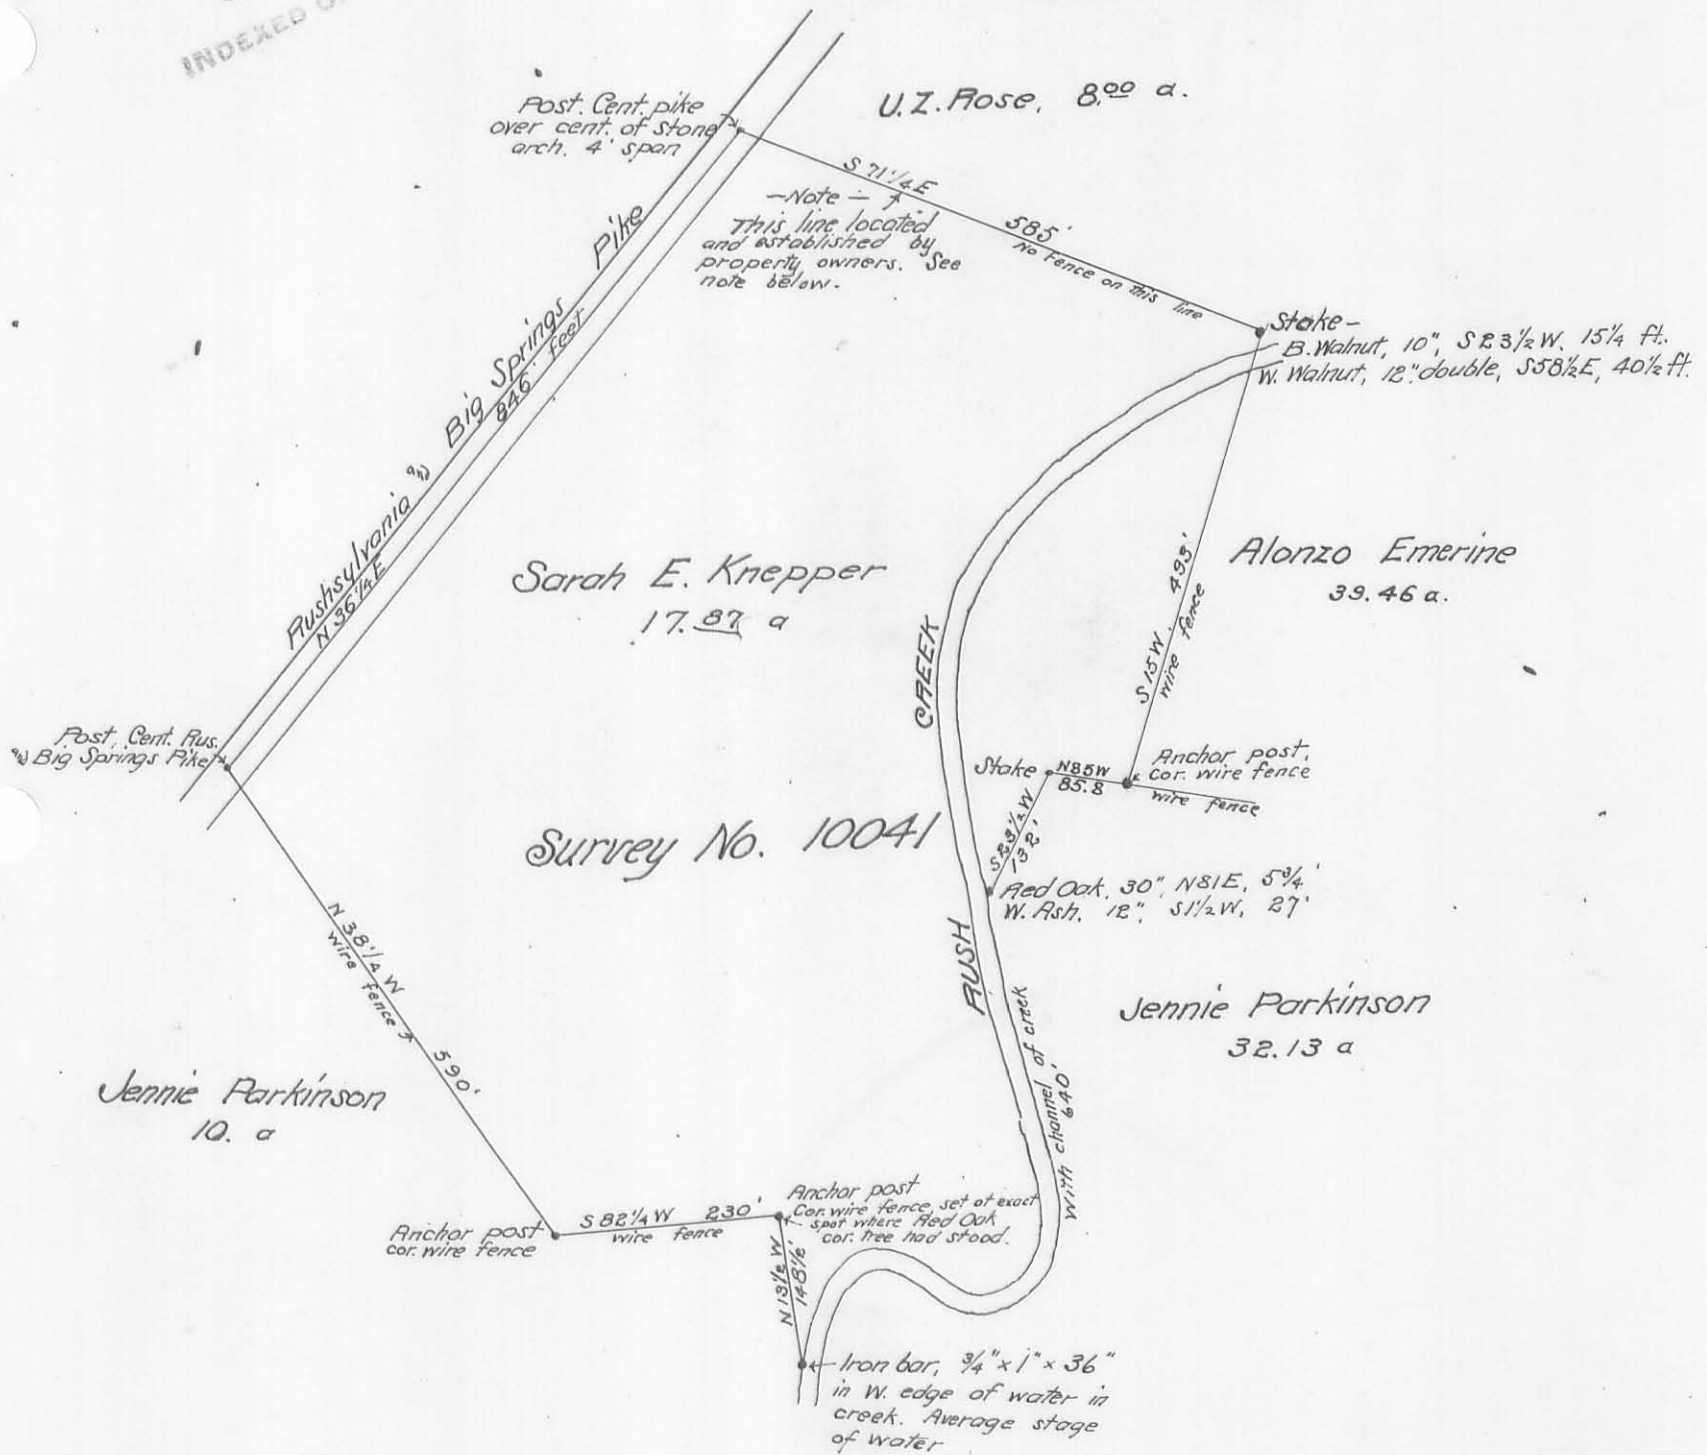

Note - The line between the lands of Sarah E. Knepper and U.Z. Rose, located and established this day by U.Z. Rose and Dr. A.V. Knepper, authorized agent for said Sarah E. Knepper.

May 14, 1907.

S.A. Buchanan,
Surveyor.