

V.M.S. 10041

V.M.S. 9936

April 11 1935  
Coal - 0200  
F. Way Mt  
E. 002

75

Road 50-12-48  
RUSHMEER Twp

Spoke corner  
Circ & post

Stone  
Local Mt  
Road

John E. Kinacy

used  
stone  
culvert

Valley Pike  
Free Turnpike  
Record NO 5  
Page 410

Stone 195.0

Walnut Grove &  
478.0

(Valley Pike 45')

CAVING

Steel  
Posts  
in  
stone

J.W. Titus

15' 0" stump

614

Page 63

SARGENT  
1861-1918

EQUILITY CEMETERY

Valley Pike  
Road 105  
21008

J.W. Titus

T. J. Watkins

Road 50

60' wide corner  
Journal 6 Page 24

V.M.S. 10301

V.M.S. 113199

Walnut

25.00

C

D

240'

Walnut Grove &  
Rush & Ivanhoe Pike  
Free Turnpike  
Record 5 Page 191

Placed stakes for fence line

A B C D E F

School  
Lot  
Vol. 78  
Page 112

Stone  
Found  
BRICK

WILL  
SHOOTS.

Corwin  
Patterson  
FILE  
BOOK 309

1644

INDEXED ON MAP


(over)

4-11-35

76

Road 50-12-48

Walnut Grove & Rushsylvania  
 Pike - Free Turnpike  
 Record No. 5 Pages 191 & 192  
 showing extra width  
 near Road 12

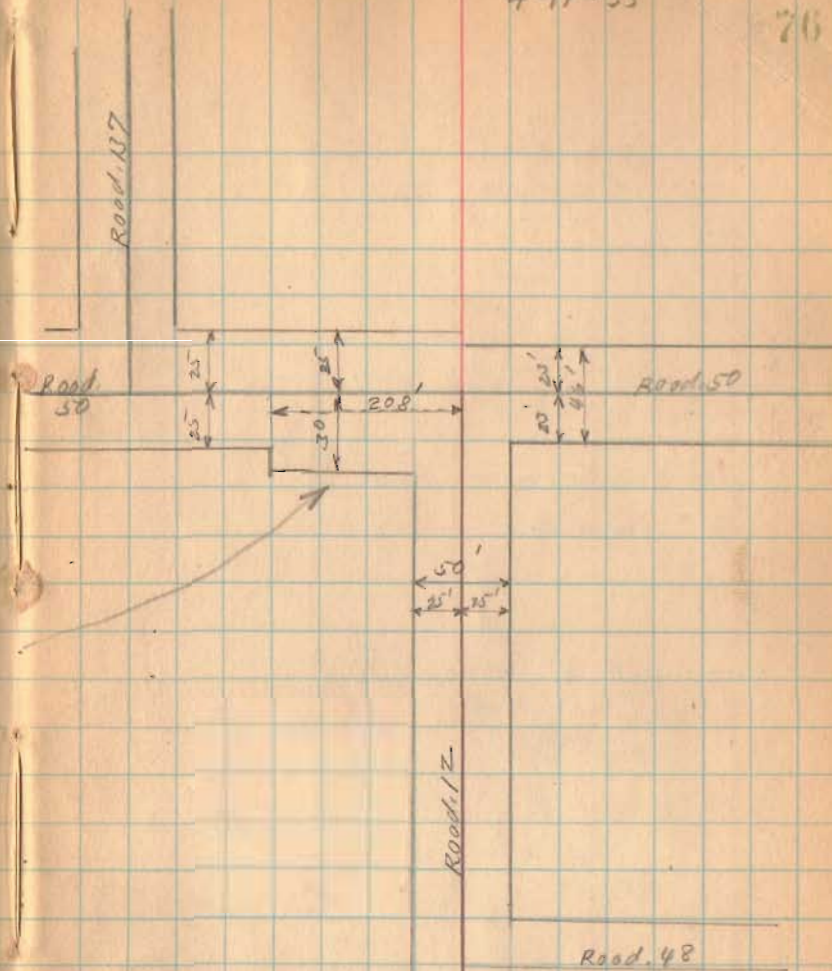

1644

INDEXED ON MAP