




Dickinson & Collum Surrey

5-17-35

46

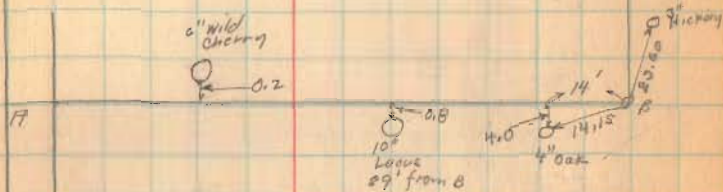

A To B 293'

1659

INDEXED ON MAP