



Iron Set  
Sta. 102+31.2  
No Angle

Iron found

Gilbert Kinney

142+31.2


"Double" Arch

10" Arch

Gortet Boring


Gilbert Kinney  
102+31.2

Paul A. McGrath

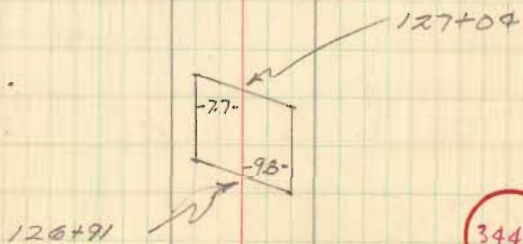

344Z

FB 701 C.H. 12

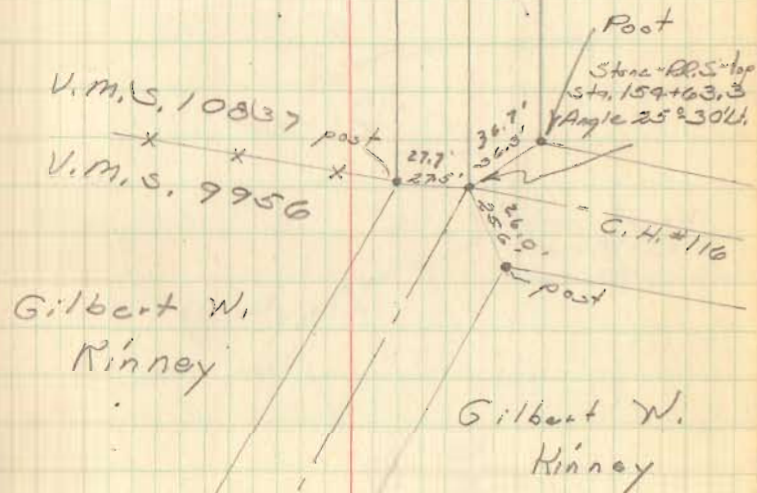


3442

INDEXED ON MAP

FB 701 C.H. 12

C.H. 115

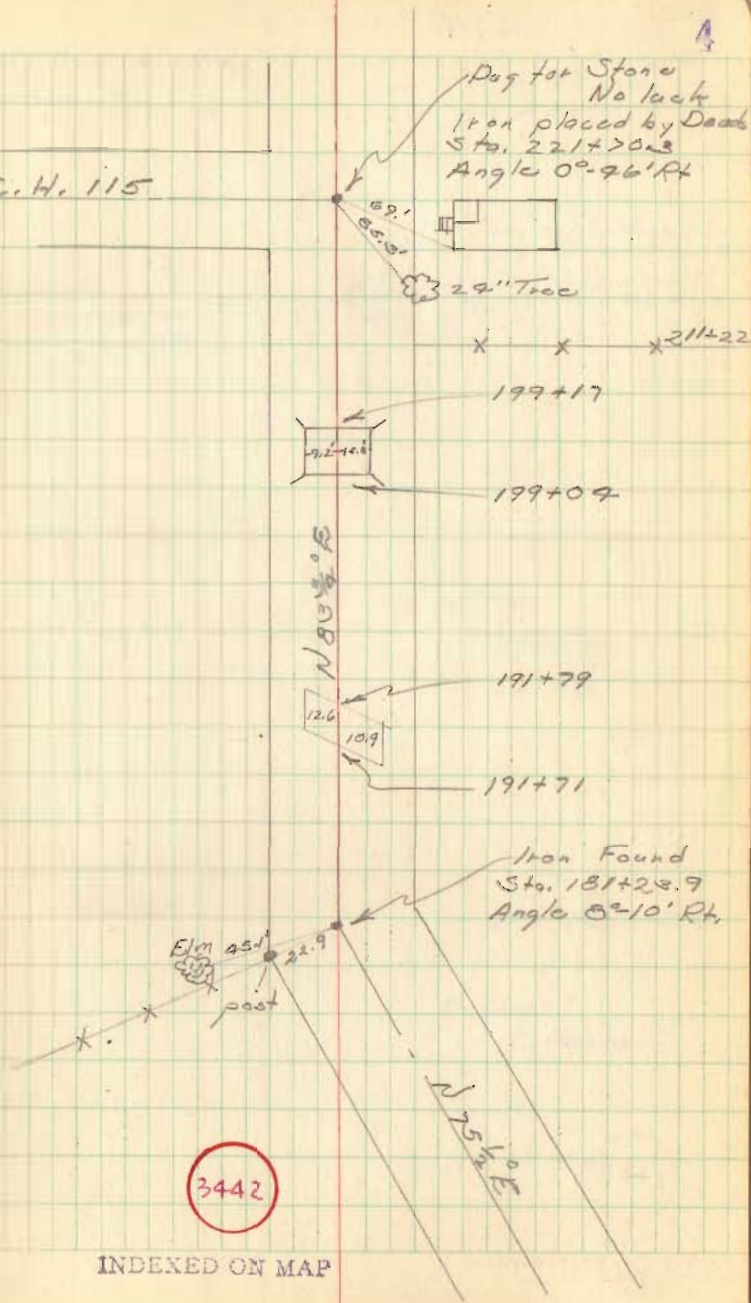

Abbie Romire  
248+01.8 — x x

← Iron found  
No Angle

Herbert  
Crankleton  
21.73

Iron - No Angle  
found 12" pin on June 27  
C.N.  
24.55 cor. post, capped nail  
27.2+37  
21.77 18" Walnut

240+15.7 — x x

N 09 1/4 E

Moud  
Ramsey  
22.78

Herbert  
Crankleton  
21.35

x x 230+09


Herbert  
Crankleton

3442

FB 701

C.H. 12

6

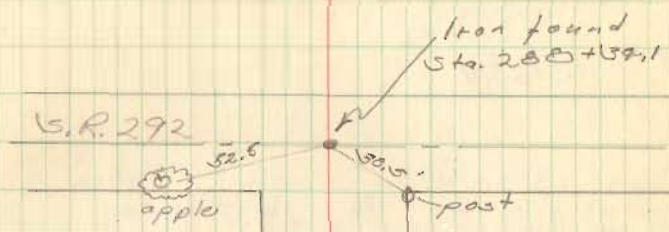

V.M.S. 16070  
 V.M.S. 14530

-265+76

Maud  
 Ramsey  
 25.00

V.M.S. 14530  
 V.M.S. 13593

Maud  
 Ramsey  
 25.32

3942