

SEE F.B. 709 PAGE 16 (10-12-84)

Fence - R/W for Meyers -

Sta.

ref. F.B. 657/38 - Fd. 3/4" #iron, old  
hub on west side, & brick (8" deep)

set stakes C.R. 110 for  
50' R/W - note 25.1' distance

Fd. 1 1/4" #iron 10" deep  
Angle Lt. 0°-01.8'  
180°-01.8'  
180°-00.0

set 3 stakes on C.R. 40 for  
60' R/W - 1830 C.V.#2

Fd. 1 1/4" #iron w. brick (8" deep)  
see F.B. 519/pg. 78, sta. 169+71  
29.1' witness to west end C.V.#2 is OK.

D.E.C.

DILL Nichols

12 June 1984

John Godwin M. Park  
1 1/2 story house

80° - sunny, breeze

T-16 & P.I. CL 450 edm

S.R. 273

85.2

1075.54'  
C.R. 110

distances  
by e.d.m.

Def. angle Lt.

Set P.K.  
P.O.T

F.D. Meyers  
40.00  
315/78.0

T.R. 51

1089.24

90°-02.2'  
270°-02.5'  
180°-00.1'


1058.32  
C.R. 40  
60' R/W

T.R. 51


RR spk.

74+80.5

FB 657/42

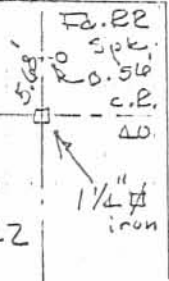

T.R. 110

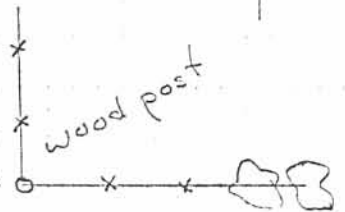

Fd. 1 1/4" #iron  
6" deep

7253 1P-1

INDEXED ON FILE

FENCE - R/W FOR MEYERS

FB 709

REF. F.B. 657/38 - FD.  $\frac{3}{4}$ " IRON, OLD HUB  
ON WEST SIDE E BRICK (8" DEEP)

SET STAKES ON C.H. 110 FOR  
50' R/W. - NOTE 25.1 DISTANCE

SET STAKES ON C.H. 40 FOR 60' R/W.  
- 1830 C.J.#2

FD.  $\frac{1}{4}$ " IRON BAR, W/BRICK (8" DEEP)

SEE F.B. 519/78, STA. 169+71

29.1' WITNESS TO WEST END C.I.P. IS OK

JUNE 14, 1984  
80° - SUNNY, BRZEZ  
T-162 & P.J. CL 450  
edm

16

