

RR SPIKE FD.  
STA. 70+00

RR SPIKE FD.  
STA. 74+50

MON. FD. 30.00'

MON. FD. 30.00'

COUNTY HIGHWAY 20

77.70'

P.K. NAIL SET



SCALE: 1" = 40'


SURVEY OF A 0.918 ACRE  
TRACT IN VMS No. 9888;  
RUSHCREEK TOWNSHIP;  
LOGAN COUNTY, OHIO; FOR  
JOHN M. ROBERTS.  
NOVEMBER 25, 1986



*Leslie H. Geeslin*  
LESLIE H. GEESLIN, P.S.  
RUSHSVLVANIA, OHIO

JOHN M. ROBERTS 88.96 Ac.  
D.B. Vol. 345 PAGE 5

INDEXED ON MAP  
7585

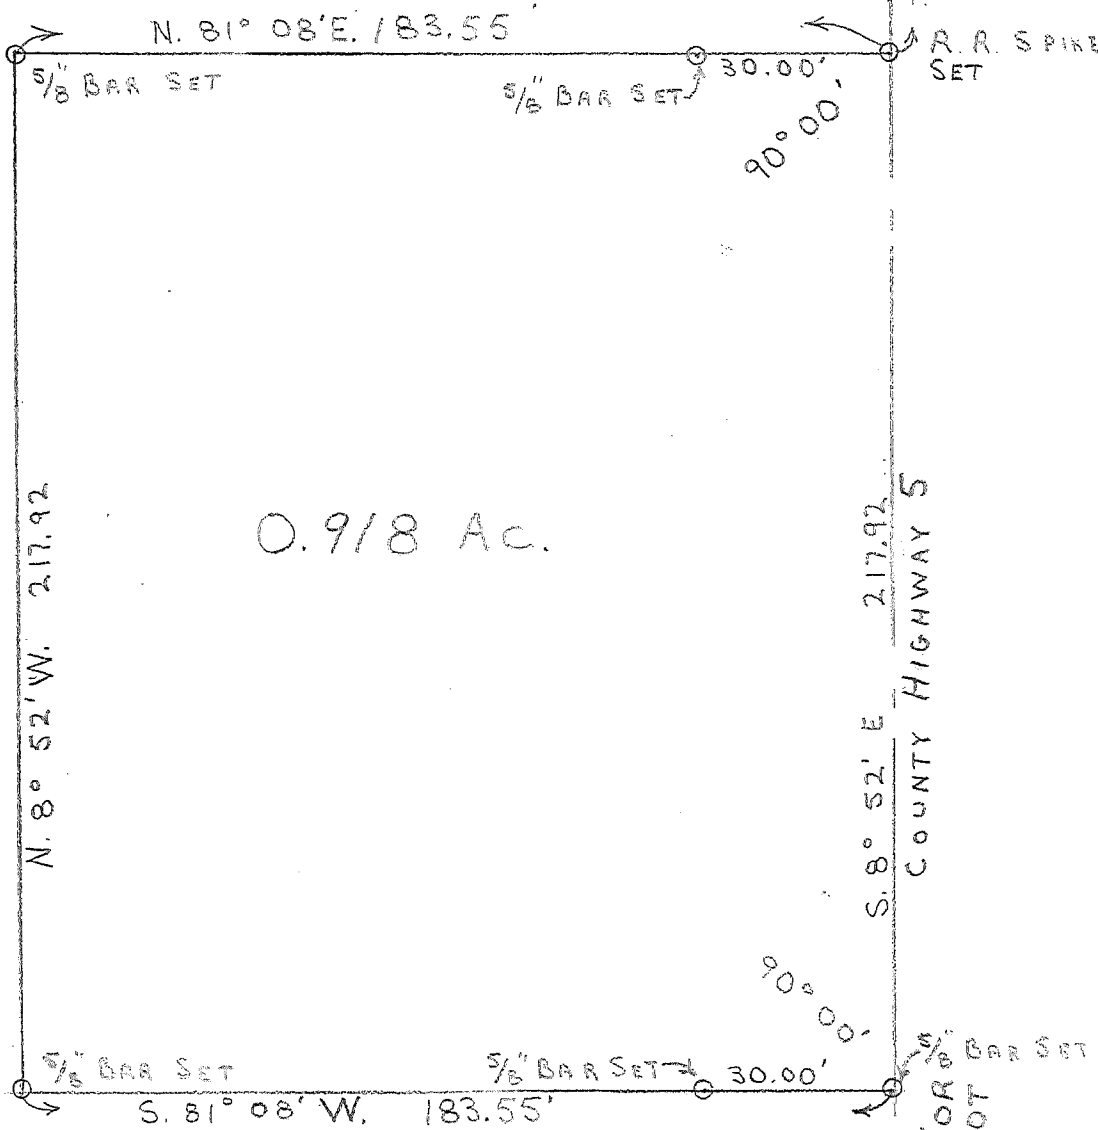

SEARCHED FOR  
STONE DID NOT  
FIND.

DRAWN BY: D.L.G.