

Received 4-22-87

(L.S) OR

LESLIE H. GEESLIN  
REGISTERED SURVEYOR NO. 5248  
P. O. BOX 274  
RUSHSYLVANIA, OHIO 43347

TELEPHONE: (513) 468-2793

GARDNER SURVEY

September, 1987

The following described real estate situated in the State of Ohio, County of Logan, Township of Rushcreek, being part of Virginia Military Survey 3326 and more particularly described as follows:

Beginning at a railroad spike in the centerline of Township Road 126 at the southeast corner of ~~Abey~~ HERRENSTEIN's 40.0 acre tract as described in O.R. Vol. 32 Page 874.

Thence with said T. R. 126 S.  $4^{\circ} 16' 45''$  E. (this bearing is assumed and all other bearings are from angles and distances measured in this field survey) 223.73 feet to a railroad spike.

Thence with the north line of ~~TEBBS~~ LOVETT's 279.02 acre tract as described in O.R. Vol. 1 Page 347 N.  $85^{\circ} 21'$  W. 197.55 feet to a wood corner post.

Thence with said ~~LOVETT'S~~ east line N.  $2^{\circ} 54'$  E. 218.93 feet to a wood corner post in the south line of said ~~LOVETT'S~~ HERRENSTEIN's 40.0 acre tract.

Thence with said HERRENSTEIN'S south line S.  $86^{\circ} 44'$  E. 202.85 feet to the place of beginning.

Containing 1.017 acres more or less.

The above described 1.017 acre tract being on the west side of LOVETT & SON'S 279.02 acre tract as described in O.R. Vol. 5 Page 863.



INDEXED ON MAP  
7681 1D


Leslie H. Geeslin

S.R. 47

LEGEND:

- A = CORNER POST FD  
B = RR. SPIKE FD  
C = 5/8" IRON BAR FD

MARY M. HERTENSTEIN  
40.0 A  
OR VOL. 32 PG. 896

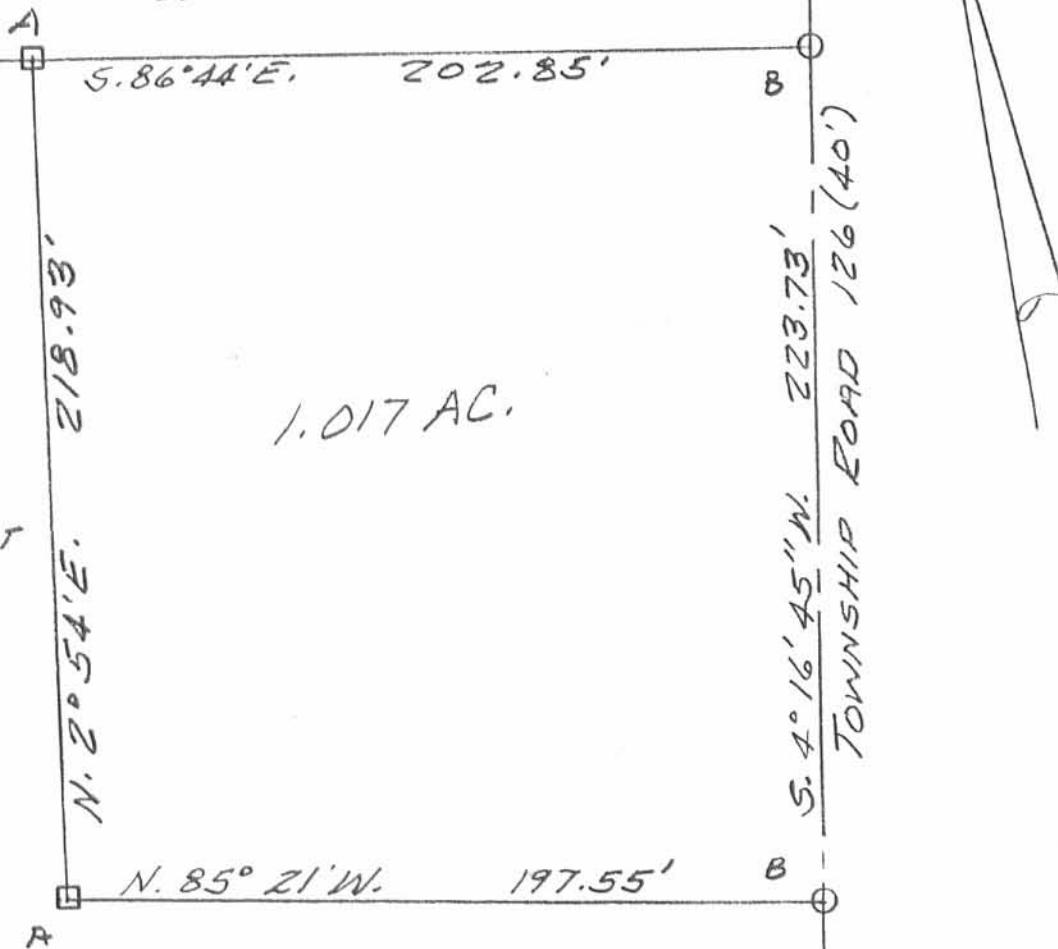

JERRY R. LOVETT  
100.63 AC  
DR 1 Pg 541

SURVEY OF 1.017 AC. TRACT IN  
VIRGINIA MILITARY SURVEY 3326,  
RUSH CREEK TOWNSHIP, LOGAN  
COUNTY, OHIO.

SEPTEMBER, 1987  
SCALE: 1" = 50'



INDEXED ON MAP  
7681 1P

Leslie H. Geeslin  
LESLIE H. GEESLIN  
RUSHCREEK, OHIO