


Sand. Pruthy 9<sup>th</sup> mo. (p.) 29<sup>th</sup> 1830 Survey No. 152

Surveyed 98 1/4 acres for Samuel Pruthy

(3252)

Beginning at a beech stump and fallen sugar tree in fallen timber it being the south west corner of Survey No 9889 and south east corner to Survey No 9888 in Porterfield's name thence with the east line of Survey No 9888 N 72° W. crossing a branch at 3 1/4 poles, 96 poles to 3 Sugar trees; thence N 78° E crossing Mill creek at 128 poles the road from Garwood's Mill to Sandusky at 154 poles, 164 poles to a stake in fallen timber in the east line of Taylor's land; thence with said line S 12° E, crossing the road and Mill creek 96 poles to a beech and sugar tree in the Green willow Swaty line; with said line S 78° W 154 poles to the beginning then run a division line beginning at 3 small sugar trees in the south line 66.6 poles, from the south east corner thence N 12° W crossing a small branch several times to 2 beeches and 1 raw horn bush in the north line - thus striking off 40 acres of the east end

2 Sugar. N 78° E 26 1/2 Stake

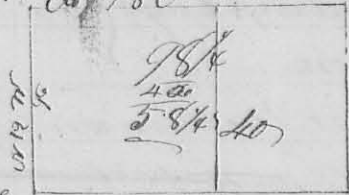

John Parkinson  
John King

J. W. Marrison  
C. S. L. Co.

Ans. Scholes 10<sup>th</sup> mo. Oct. 7<sup>th</sup> 1830

Survey No 153

(3253)

Surveyed 140 acres for John Scholes

Beginning at in the west line of Sec 32 Town 3 R. 14 M. P. 24 poles north of the south west of said sec. thence east 162 poles crossing the road from Bellefontaine to Sidney to a stake in a prairie 24 poles north of the gr. sec corner on the line between Sect 31 & 32; thence north 138 poles to a stake in the center of the sec. where a bur oak bears N 48° W 44 links - thence west 162 poles (crossing the roads) to a white oak 24 inches Diam corner tree in the west line of the sec; thence with said line south 138 poles to the beginning;



Robert Hurlbut & Wm Moore

J. W. Marrison  
C. S. L. Co.