




Dec. ✓ 1835

N<sup>o</sup> 301 Surveyed Dec. 16. 1835 for Michael Muffelman the following tract of lands to wit Beginning at a stake from 3 poles from the South Easterly, comes to Lincoln McArthur's Survey N 10 40 E & 10 179. then N 80 E 126 poles, crossing Rush Creek at 84 & small branch at 110 poles, to an Elm Ash & Gum, then N 12 W 138 poles, crossing Rush Creek at 118 poles, to an Elm & 2 others on black & Gray, then S 26 W 196 poles, crossing a bend of Rush Creek at 104 poles, to the beginning containing 27.16 acres.  
 M. Muffelman }  
 J. Muffelman } ch. can.  
 D. Hopkins S. G.

13523

8359

N<sup>o</sup> 302 A part of N 4493 Surveyed Dec. 21. 1835 for Land Sturtevant Beginning at a Crab Apple bush in the edge of a prairie, then S 70 W 134 poles, crossing a big road & small branch several times, to a stake on the top of a ridge near a hickory & small Jack Oak stub, then N 38 E 93 poles, to small W. & 66. Oak. then N 67 E 121 poles, crossing the big road a small river stream to a stake in a bunch of willows on the bank of the river, then N 20 W 84 poles, crossing the river twice to the beginning. Containing 78 acres 60 hundredths.  
 L. Sturtevant }  
 Derby, Sonny } ch. new  
 D. Hopkins S. G.

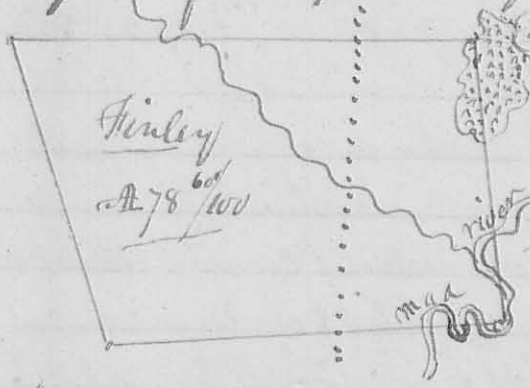

N<sup>o</sup> 303 Surveyed for George Sturtevant & Hickory in Iowa territory Jan'y 22. 1836. Beginning as at our marker, then S 85 E 100 poles, then N 73 W 112 poles, to a stake in Big road. then West 282 poles, then North 50 poles, then East 147 poles, to beginning. branch at 126 poles.  
 George Sturtevant }  
 Hickory }  
 D. Hopkins S. G.

8365

