

January

1836


231

and ash, thence S12E 202 poles to a Sugar and two
ironwoods, thence S78W 95 poles to three Beech, thence N12W
202 poles to the beginning. Containing 120 acres.

Divided by A. Latham to said Claggs. - Divi-
ded by me on the 22nd of January as follows. Beginning
at a stake about one pole Northwesterly from a Beech, 25
poles, S12E from the NW corner of said 120 acre lot -
thence S38E 162 poles to the NW line of Rushsylvania, at
the westerly end of Rush Street, a stake in a county road
thence S38W to the SW corner of said town, thence S58E to
the south line of said lot, thence with said line S78W to 3 Beech
at SW corner thereof, thence N12W 177 poles to the beginning
Containing 216 1/2 acres, (more or less) for iron claggs, and
from said stake at the end of Rush Street in a county
road in the NW line of Rushsylvania N32E to the NW
corner of said town plat, thence S38E with said plot to
the East line of said 120 acre lot, thence with said line
N12W to two Beech and ash, N.E. corner of said lot,
thence S78W 95 poles to 2 Beech & ironwood, thence S12E 25 poles
to the beginning of said Division line. Containing
6.6 1/2 acres, for J.B. Claggs. - Jan'y 22, 1836.

David Hopkins Surveyor
D.C.

N^o 306

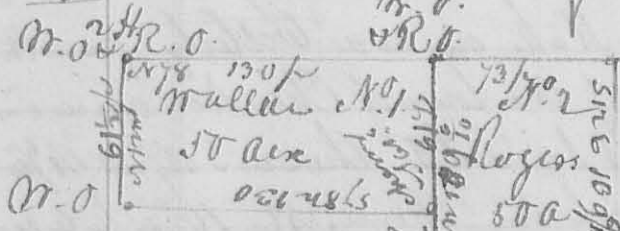

Surveyed for E. H. Adams part of
Military Survey on warrant
N^o 4688. Beginning at a
Hickories, White Oak & Red Oak
center of the west line of the
Survey, thence S12E 65 poles
to a White Oak, thence N78E
130 poles to two Black Walnuts from one root Lassafras & wild Cherry
all S in all, thence N12W 65 poles to White Oak & Red Oak, thence
S78W 120 poles to the beginning, Cont'g 30. N^o 1. for N^o 1. Begin-
ing at a m.o. thence S12E 109 1/2 poles to Red Oak m.o. thence S78W 73 poles to 2 Red Oaks
thence N12W 109 1/2 poles passing Wallace corner at 48 poles to Red O. & N. 1. thence
N78E 73 poles to beginning Cont'g 30 Acs. David Hopkins S. L. C.
Jan'y 22, 1836

130 poles to two Black Walnuts from one root Lassafras & wild Cherry
all S in all, thence N12W 65 poles to White Oak & Red Oak, thence
S78W 120 poles to the beginning, Cont'g 30. N^o 1. for N^o 1. Begin-
ing at a m.o. thence S12E 109 1/2 poles to Red Oak m.o. thence S78W 73 poles to 2 Red Oaks
thence N12W 109 1/2 poles passing Wallace corner at 48 poles to Red O. & N. 1. thence
N78E 73 poles to beginning Cont'g 30 Acs. David Hopkins S. L. C.
Jan'y 22, 1836