

Lot 215  
 RUSHESVILLE, OHIO

Pins on front (@ street)  
 Set 31.0 feet from E of St.  
 Conc. walk @ 30.1'

- A Joint in conc. walk @ fence
- B 1" pipe set - 0.85 E. of walk
- C  $\frac{5}{8}$ " Bar Set - " " " "
- D P-K nail set @ S. line of alley
- E t&d hub set
- F  $\frac{5}{8}$ " Bar Set
- G  $\frac{5}{8}$ " Bar Set

B - 6" maple N.E. 14.0'  
 Cor. House S.E. @ porch 33.80'

C Cor. House N.E. 24.00'  
 Cor. Church S.E. 31.35'  
 0.8' S. of end of conc. walk

Deed - 150' off the West end of lot 215

A to B meas 224.0 feet


Meas from C to fence @ S.W. cor.  
 Church property 232.3'

INDEXED ON MAP  
 9613

Dodson  
 G. Geeslin

8-19-61

11

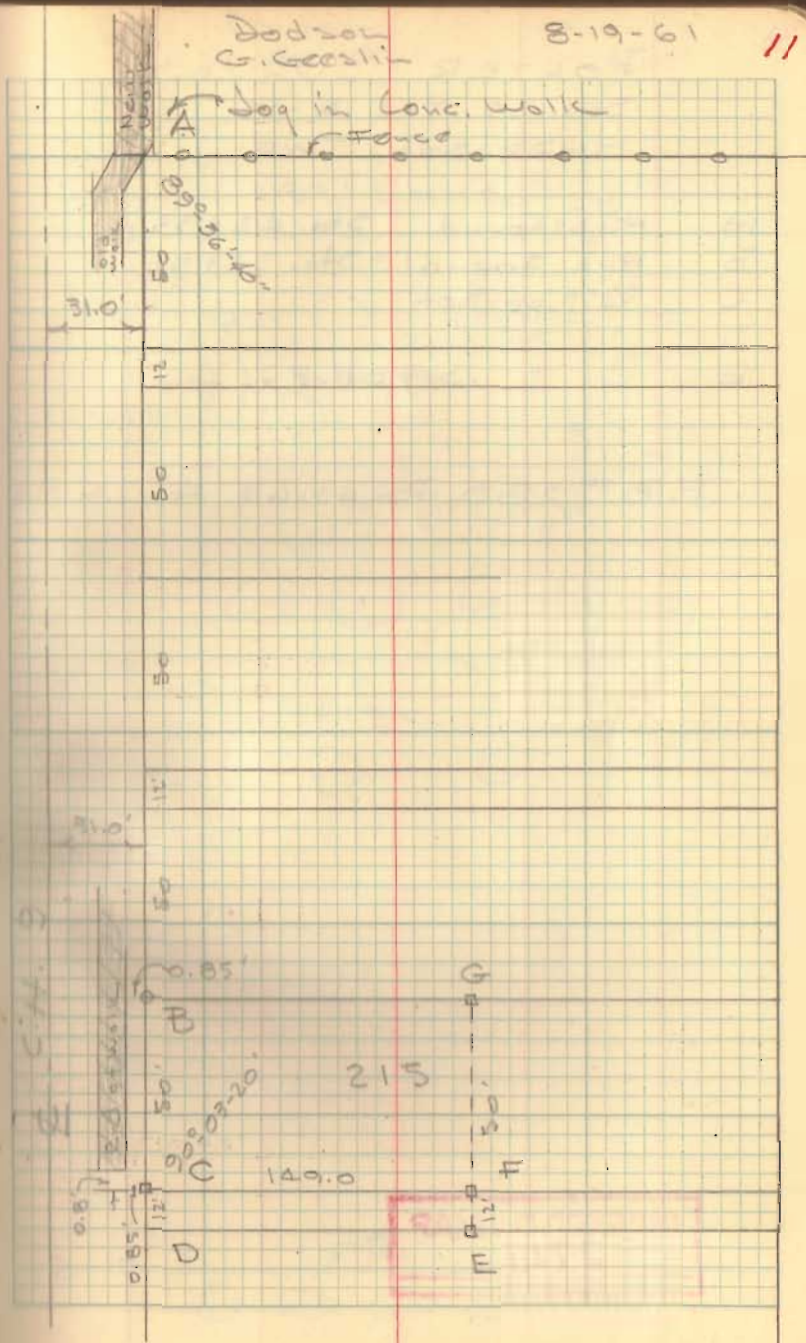

38  
Lot 215  
Rushsylvania

89-56-40

178-113-22

179-<sup>02</sup>  
-53

174  
50  
224

Pin on front set 31.0  
feet from E St.  
walk @ 30.0'

179-60

89-56-40

90-3-20


- A = Joint in conc. walk of fence  
B 1" pipe set  
C  $\frac{5}{8}$ " Bar set  
D P-K nail set S. line alley  
E 1kd. Hub set  
F  $\frac{5}{8}$ " Bar set  
G  $\frac{5}{8}$ " Bar set

- B 6" maple N.E 14.0  
Cor. house S.E @ park 33.80  
C Cor House N.E 24.00  
Cor Church S.E 31.35

INDEXED ON MAP

9613

23

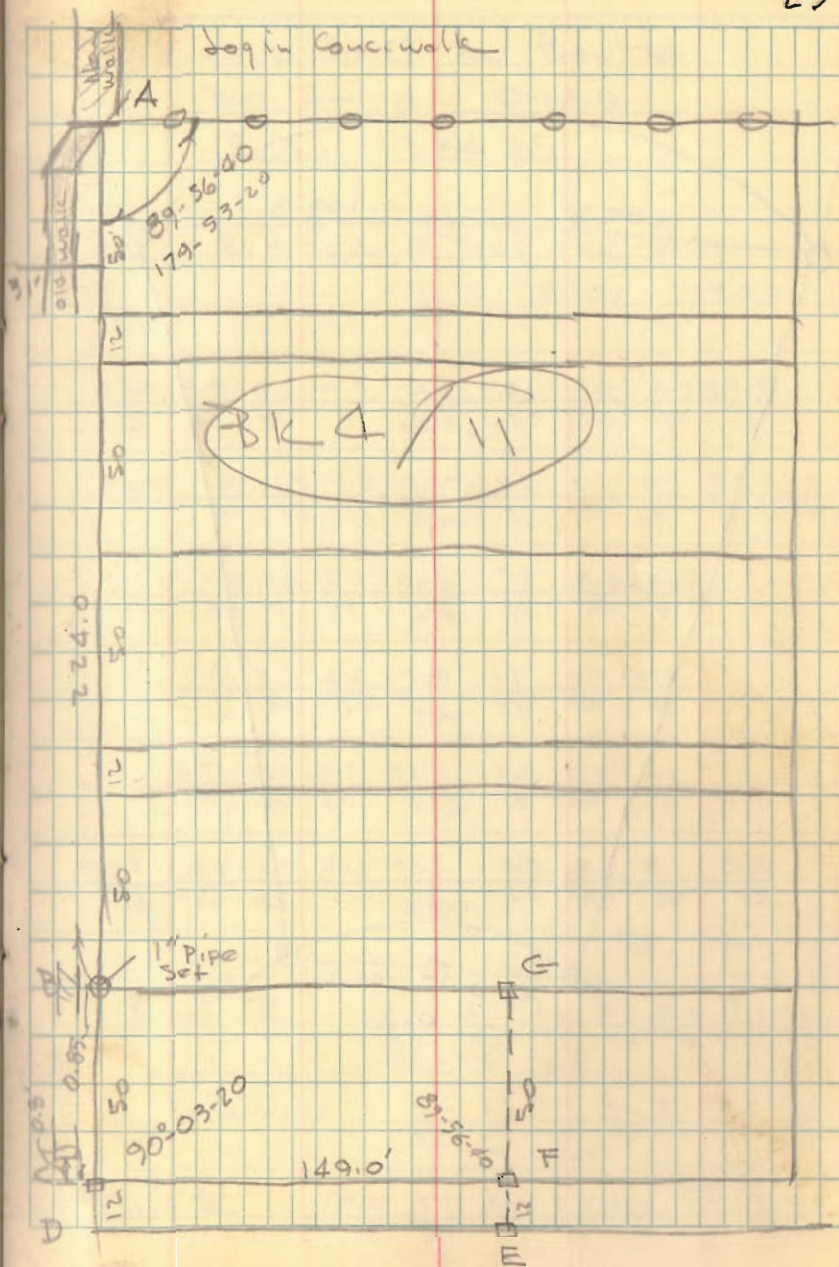

Sandusky Street  
C. H. No. 9

30'

Conc. Walk

50'

C

89°57'

214

150'

D

215

50'

B

150'

E

12'

90°03'

12' Alley

89°57'

12'

A

216

- A = nail set -
- B = 5/8" Bar set
- C = 1" Pipe set
- D = 5/8" Bar set
- E = 5/8" Bar set
- F = tkd. hub set

A-B-C set 31.0'  
from E Sandusky St.

Ref:

Fawcett Addition

Plat Bk B

Vol. 2

Page 71

Co. Eng. F.B # 518, pg. 51

Survey of  
Pt. Lot 215  
Bucksylvania, Ohio

for  
L. R. Roberts  
Deed Vol. 228

Page 258

Don L. Dodson

Registered Surveyor  
No. 4270 - Aug. 18, 1961

INDEXED ON MAP  
9613 1P