

SANDUSKY STREET

RUSH STREET




SURVEY OF PT. LOTS 9 & 10
 RUSHSYLVANIA, OHIO
 FOR
 THE LOGAN COUNTY BANK
 JUNE 19, 1971
 SCALE 1" = 10'

DAN L. DODSON
 REG. SURVEYOR 4270
 BELLEFONTAINE, OHIO

SANDUSKY STREET (70')

C.I. SEATE 1.6' X 3.0'
FILE 16.34 FLOWLET =
96.65

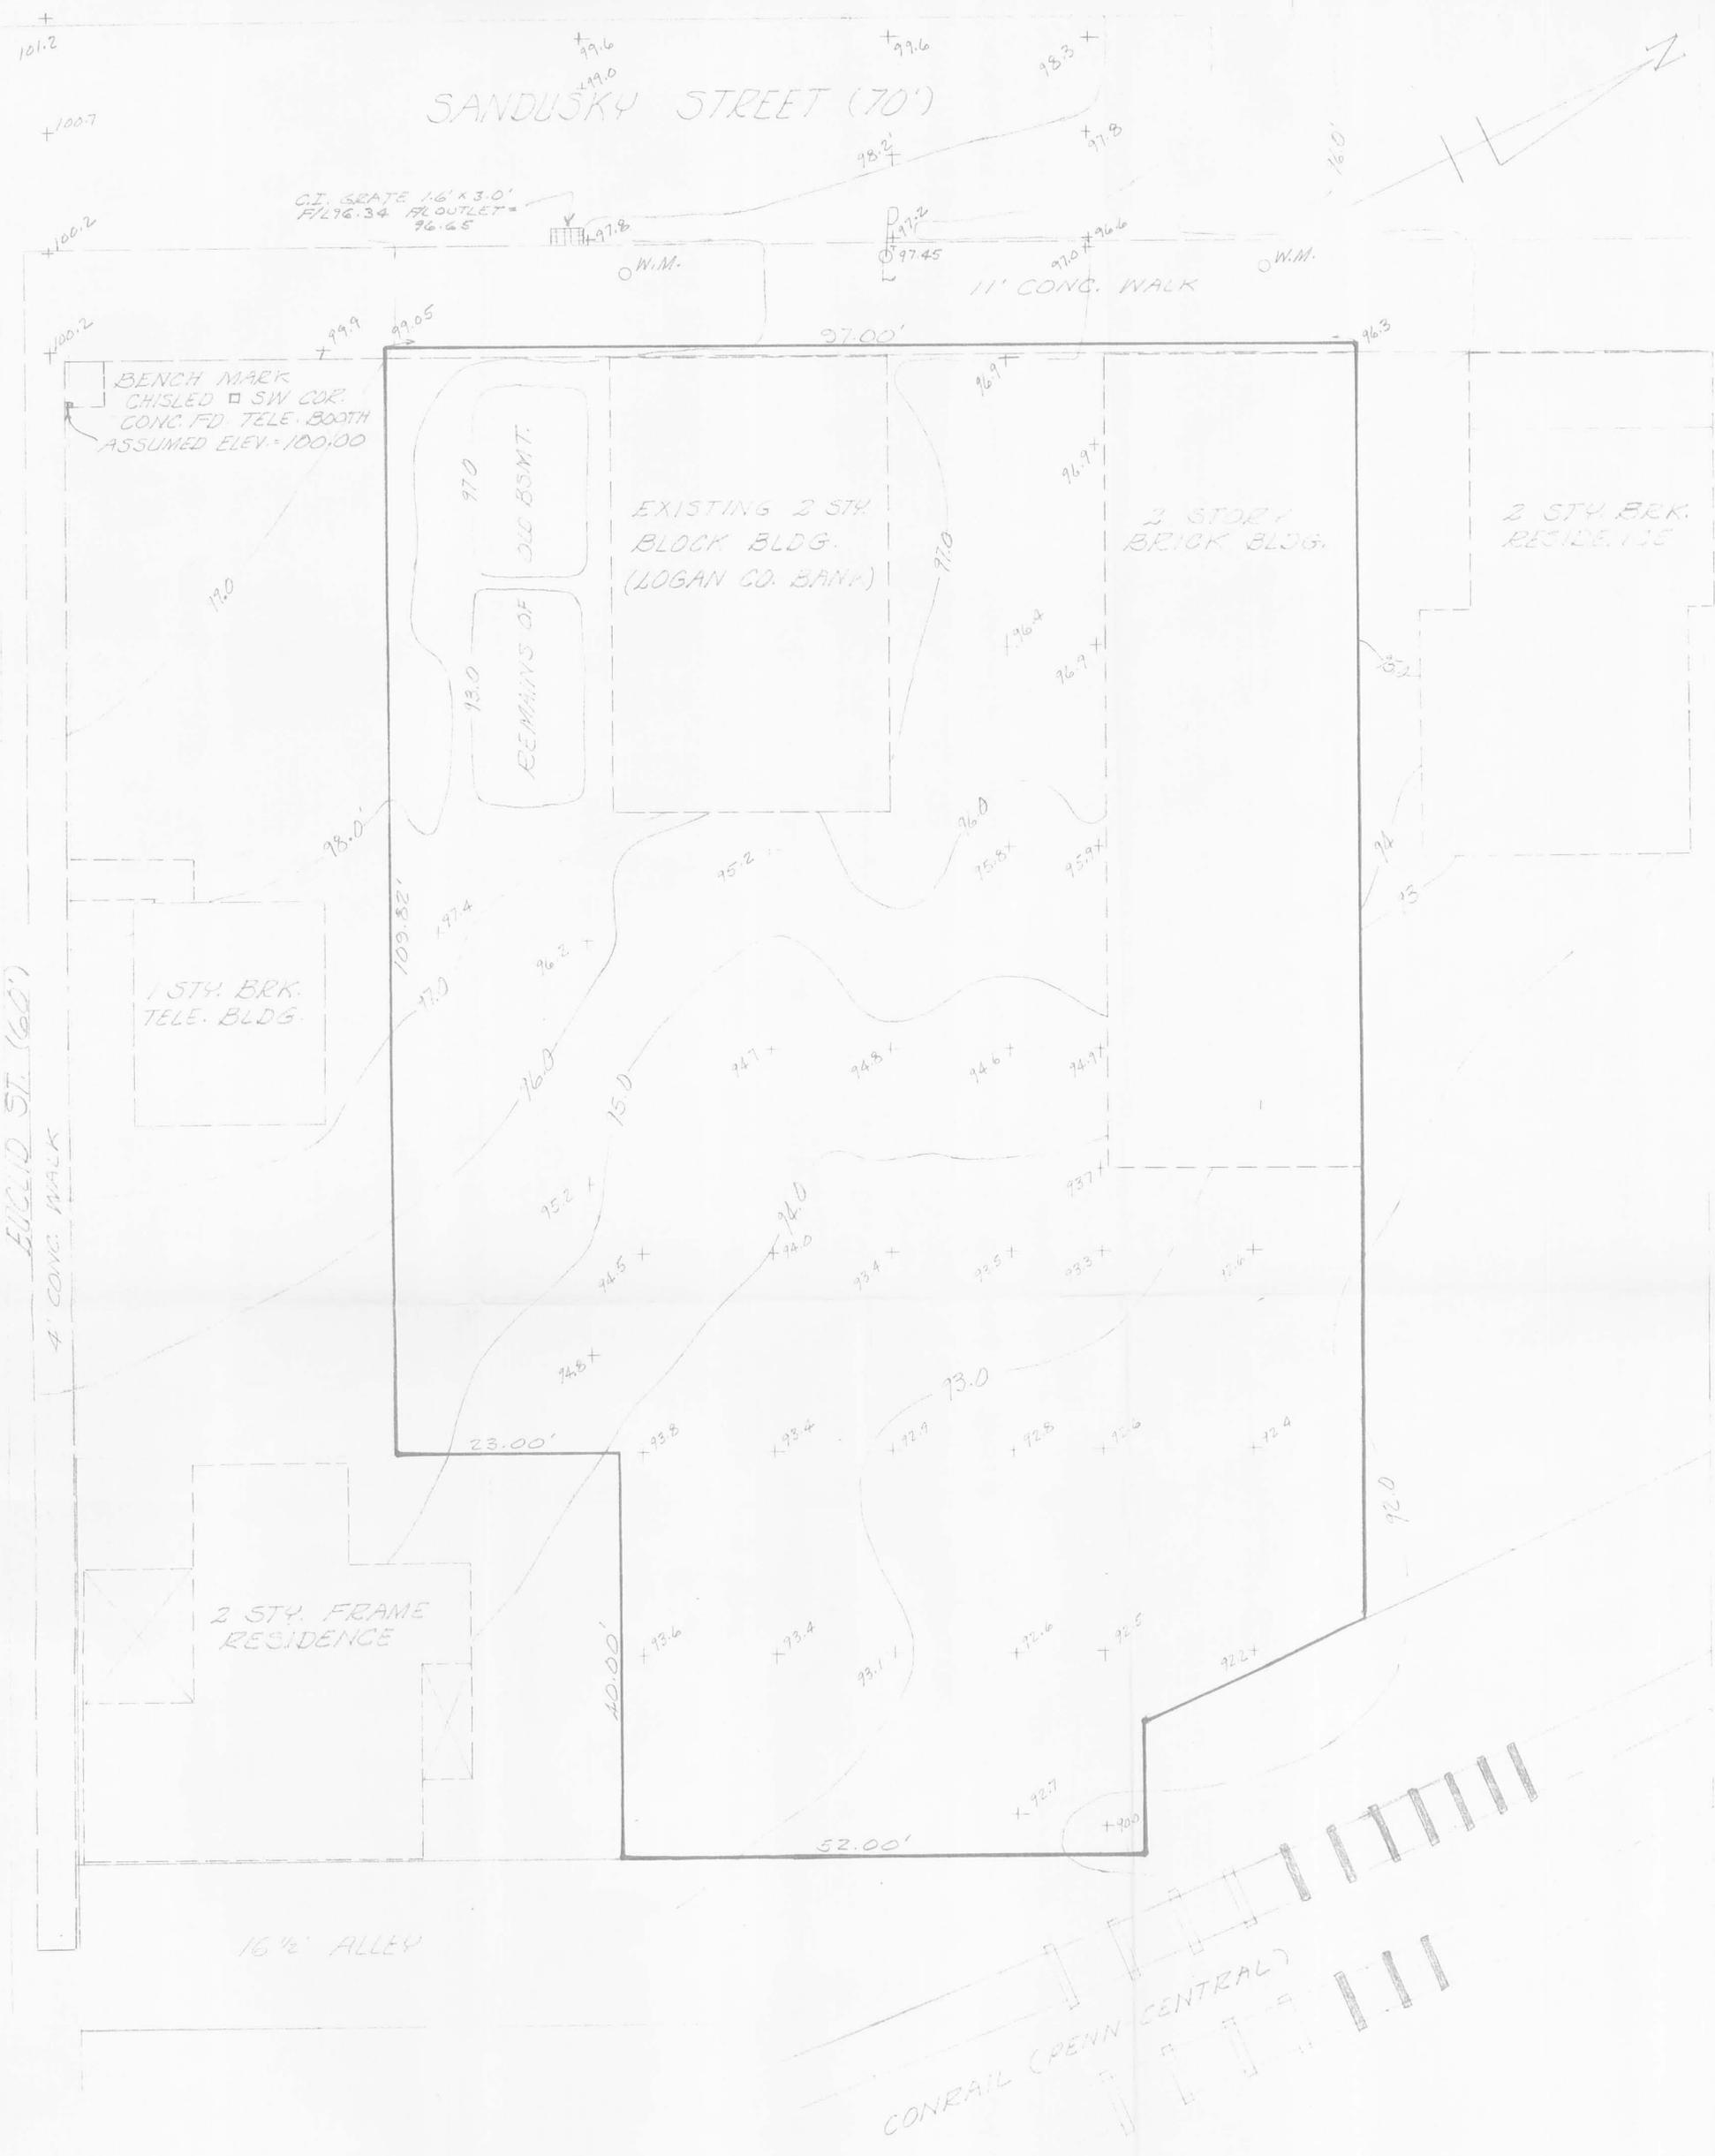


TOPOGRAPHIC SURVEY OF THE LOGAN
COUNTY BANK PROPERTY IN RUSHSVLVANIA,
OHIO ON PART LOTS 9-10-11
NOVEMBER, 1978
SCALE 1" = 10'

4167 IP
INDEXED ON MAR



LESLIE H. GEESLIN
RUSHSVLVANIA, OHIO

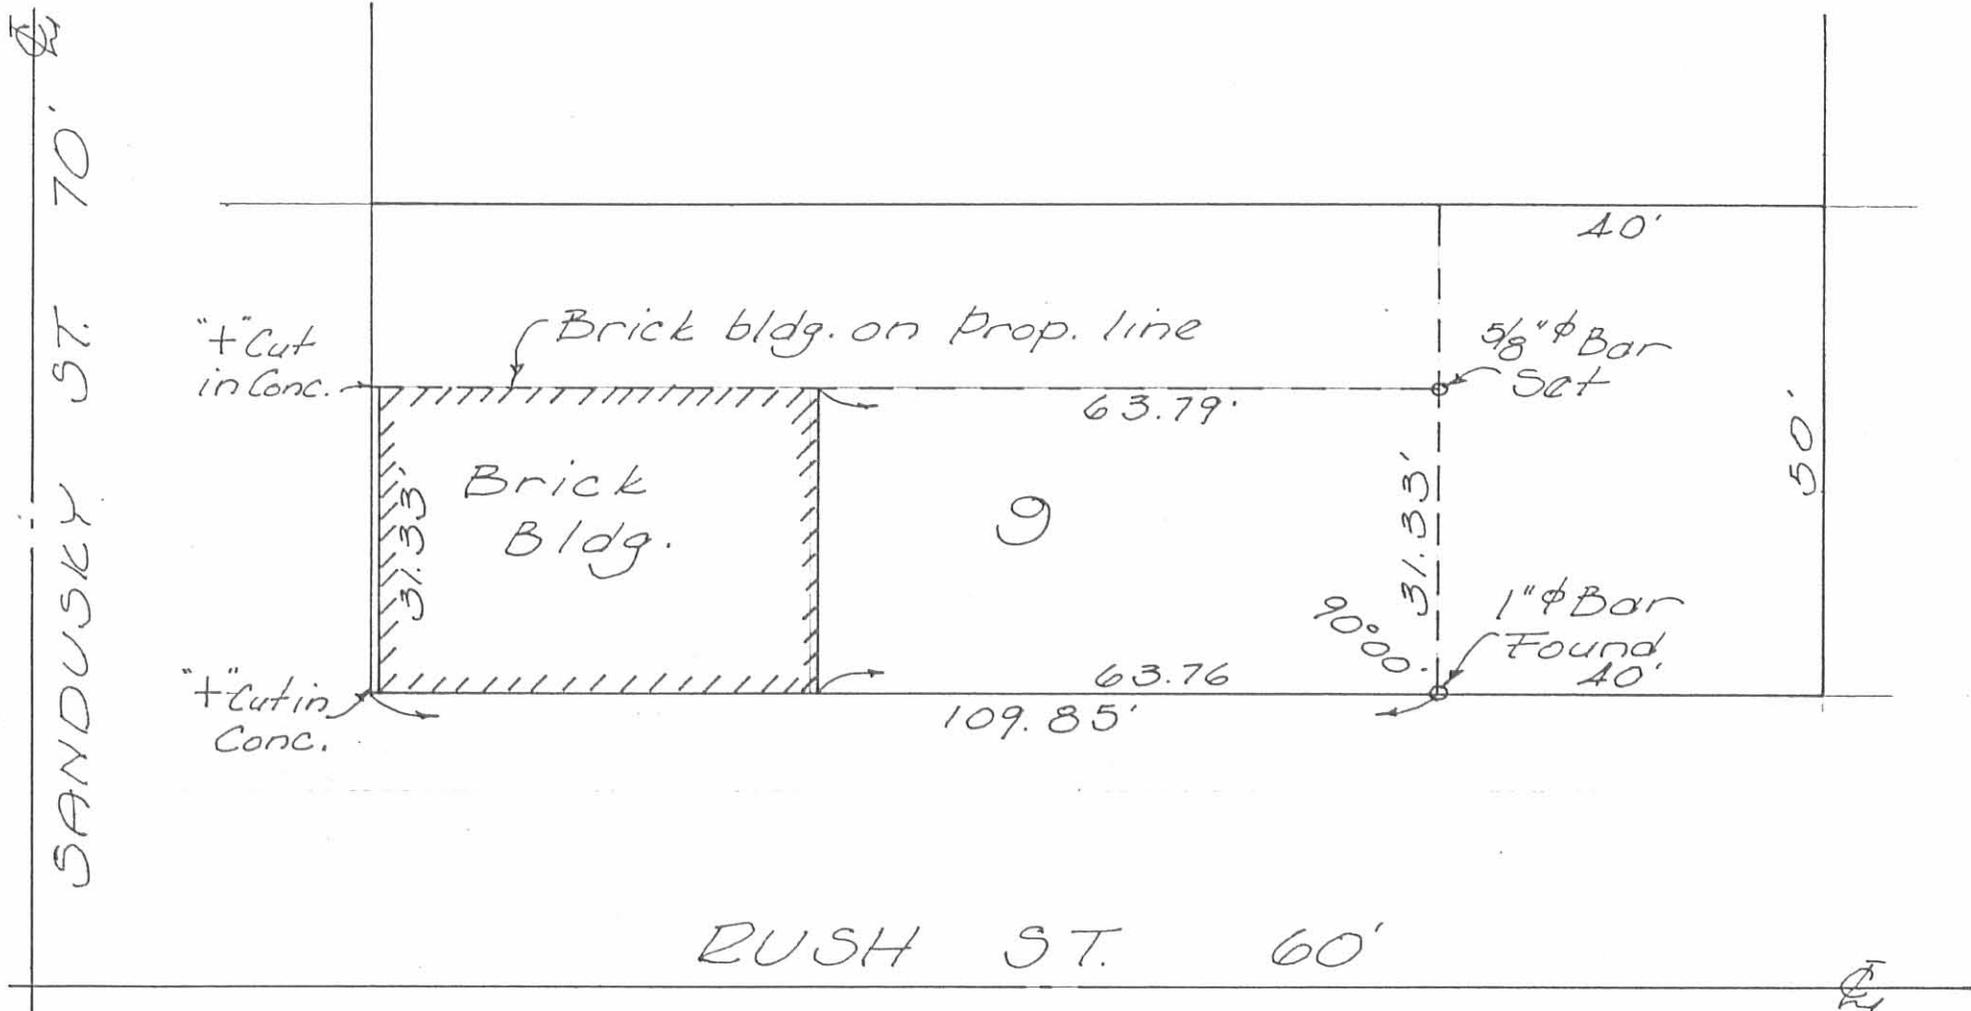

SURVEY OF PART LOT 9
 RUSHSYLVANIA, OHIO
 JULY 25, 1967
 FOR
 THE LIMA TELEPHONE COMPANY

SCALE 1"=20'

INDEXED ON MAP
 4167 ZP

Dan L. Dodson

Dan L. Dodson
 228 N. Park
 Bellefontaine, Ohio
 Reg. Surveyor 4270

PT. LOT 9 & 10
RUSHSVLVANIA, OHIO

A = 1" ϕ BAR FOUND 9" DEEP

B = $\frac{5}{8}$ " ϕ BAR SET

C = " " "

D = HUB SET

E = $\frac{5}{8}$ " ϕ BAR SET

F = " " "

G = " " "

H CHISELED + ON CONC WALK

I " " "

J " " "

See Bk 4 pg. 73 for survey of
Pt. Lot 9

INDEXED ON MAP
4167

DODSON
Brooks

6/19/71
75°

00

