

LESLIE H. GEESLIN
REGISTERED SURVEYOR 5248
P. O. BOX 274
RUSHSYLVANIA, OHIO 43347
TELEPHONE: (513) 468-2793

ZIMMERMAN SURVEY

February 5, 1995

The following described real estate situated in the State of Ohio, County of Logan, Township of Rushcreek, being part of Lot 77 and all of Lot 78 of Wilson Addition to the Village of Rushsylvania and mor particularly described as follows:

Beginning at a 5/8 inch iron bar found at the northwest corner of Lot 78 in the east line of Walnut Street.

Thence S. 58° 35' 00" E. 150.00 feet to a 5/8 inch iron bar found in the west line of a 16.5 foot alley.

Thence with said west line S. 32° 00' 00" W. 52.00 feet to a 5/8 inch iron bar found, passing the southeast corner of Lot 78 at 50.00 feet.

Thence N. 58° 35' 00" W. 150.00 feet to a 5/8 inch iron bar found in the east line of Walnut Street.

Thence with said east line N. 32° 00' 00" E. 52.00 feet to the place of beginning, passing the southwest corner of Lot 78 at 2.00 feet.



Bearings are based on an assumed bearing (N. 32° 00' 00" E.) for the east line of Walnut Street in this field survey by Leslie H. Geeslin .



Leslie H. Geeslin

INDEXED ON MAP
4247 ID

LEGEND:
 O = 5/8" IRON BAR FOUND

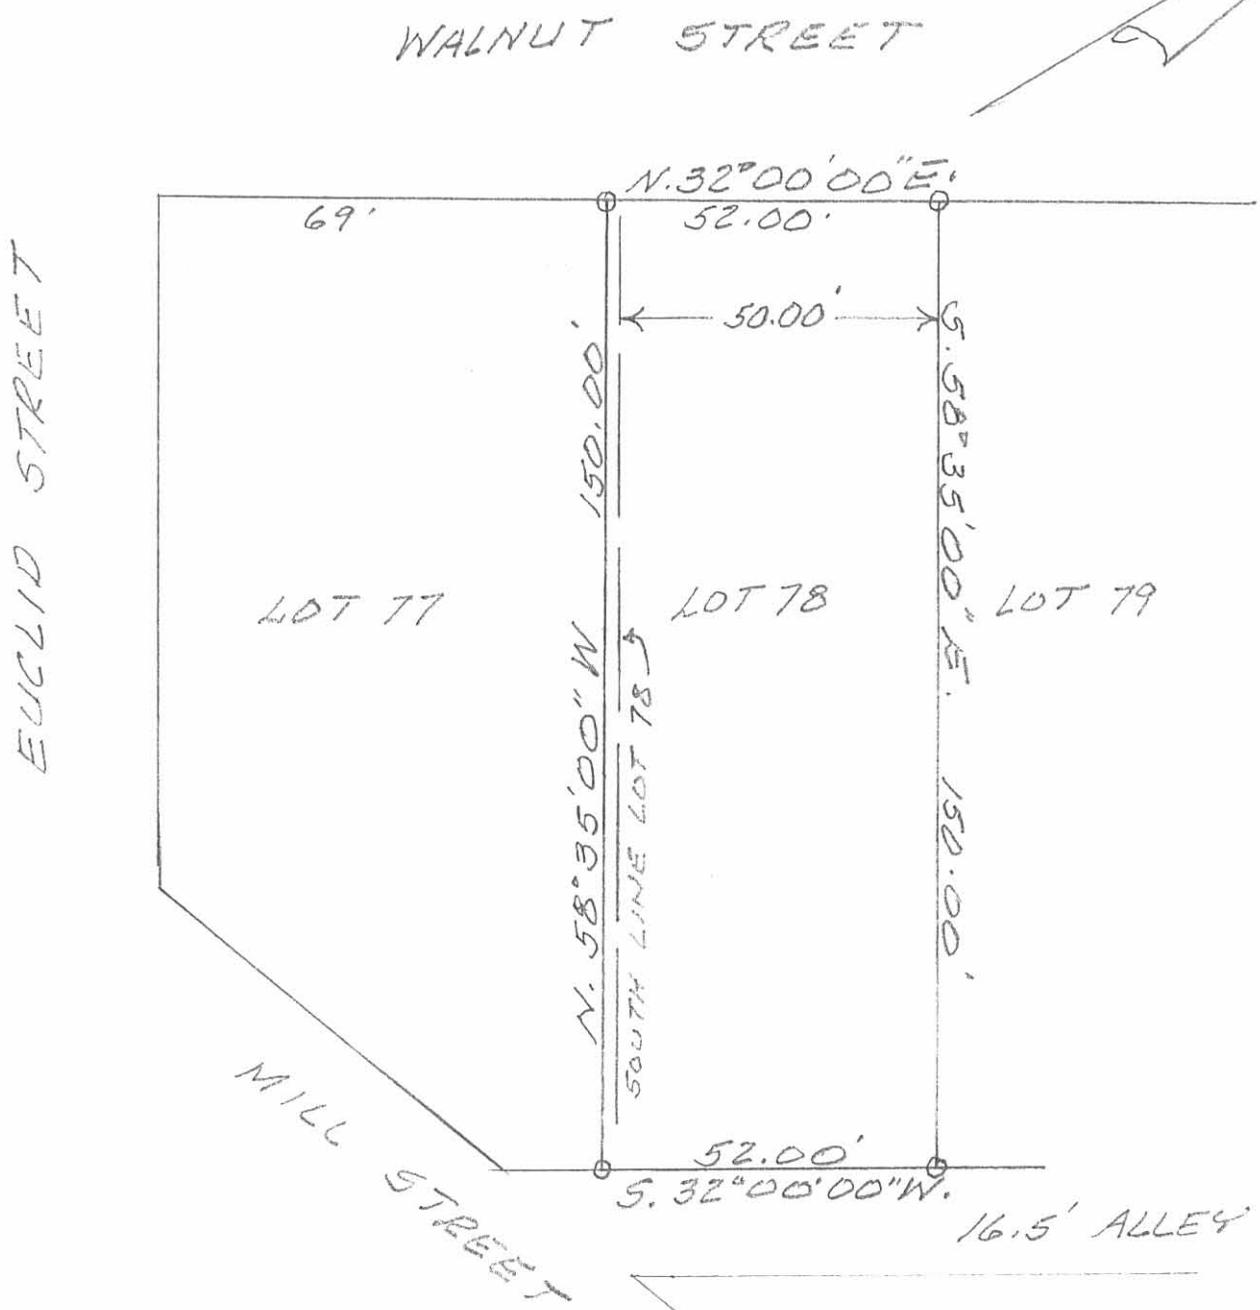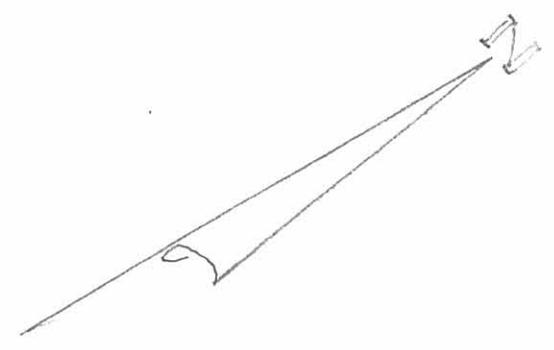


SURVEY OF PART OF LOT 77 AND ALL OF LOT 78 IN WILSON ADDITION TO THE VILLAGE OF RUSH, SYLVANIA, RUSHCREEK TOWNSHIP, LOGAN, OHIO FOR ELDON ZIMMERMANN, FEBRUARY 5, 1995
 SCALE: 1" = 30'




Leslie H. Geeslin
 LESLIE H. GEESLIN
 RUSH, SYLVANIA, OHIO
 PH 513-468-2793

INDEXED ON MAP
 4247 1P

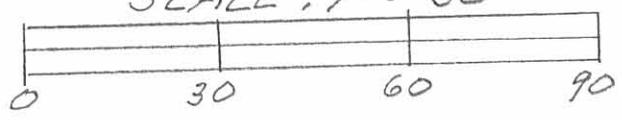


PLAT OF A SURVEY
 OF LOT 78 AND
 2' OF LOT 77 IN
 THE VILLAGE OF
 RUSHSYLVANIA,
 LOGAN COUNTY, OHIO

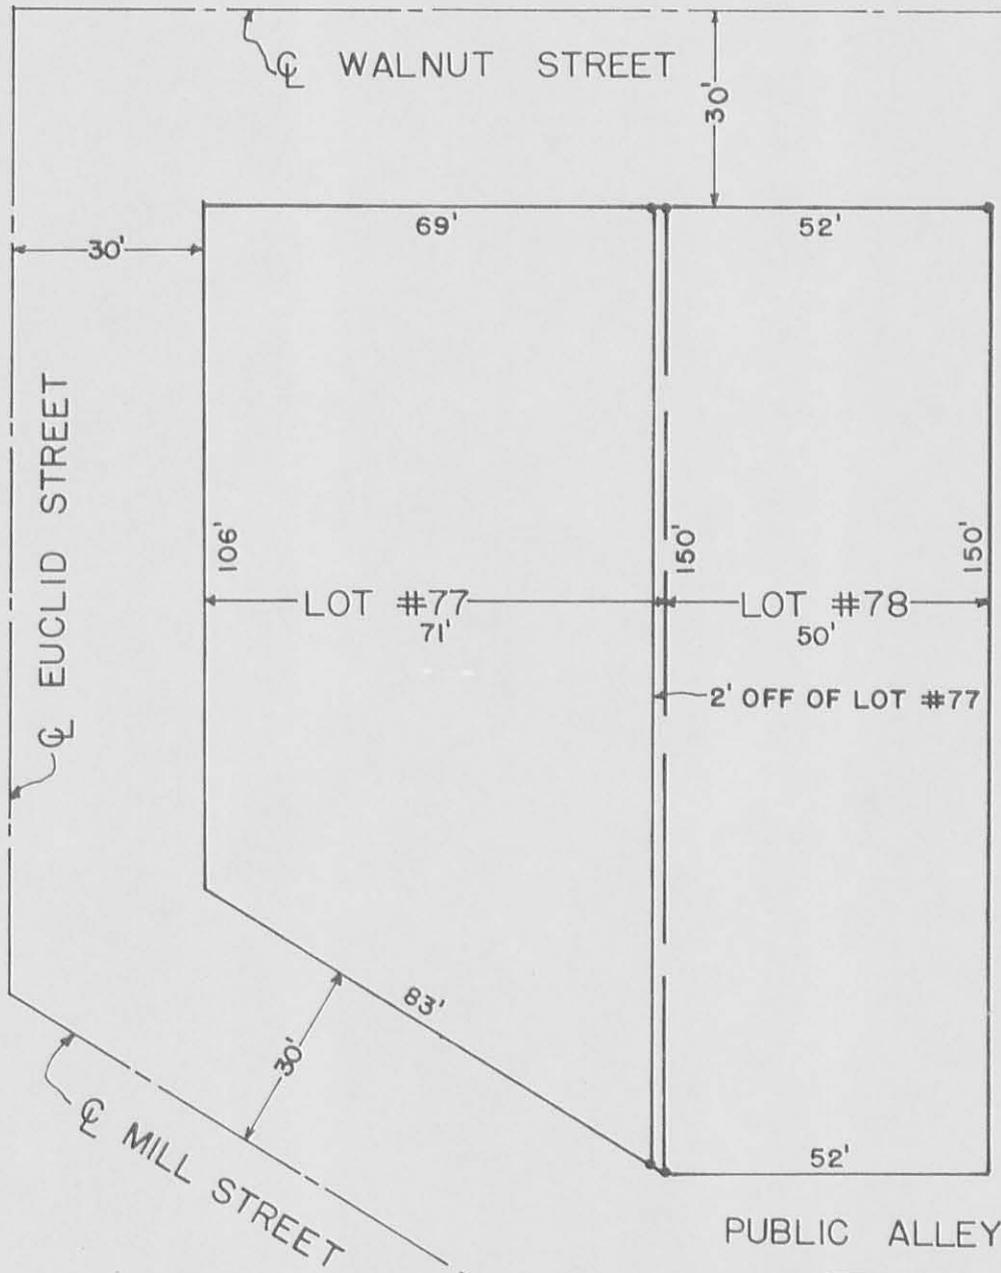

Thomas C. Hubbell
 Reg. Surveyor #5044

4247 2P
 INDEXED ON MAP

SHELDON ENGINEERING

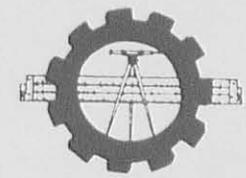

LIMA, OHIO

18 JULY 1968	DATE	JOB NO. 06460
DRAWN	DF	
CHECKED		SCALE 1" = 30'
APPROVED		