

Lamb Survey Lot. 10
Spring - Grave Russel Point.

Sec. 36 T. 6 R. 8

Lots shown as in Plat Book


- A - Iron Pipe Found, This iron is 6'-1"
from lot corner By measurements to B,
B - $\frac{1}{2}$ " Iron Found
C $\frac{1}{2}$ " Iron Piped By Wright
D $1\frac{1}{2}$ " Pipe " " "
E Stake " " "
F " " " " on line
G " " " " " "

Found Iron B. Measured as shown
Placing other stakes as shown.

Measured To C. and set lot lines at
90° from St. Back corners of lot not
set due to swamp. Mr. Lame says
line DG O.K. as in passes old
rose bush which he set on line.

See Next Page for witnesses.

Sat. Aug-11-1978 45
clear
Wright
Bill Wright

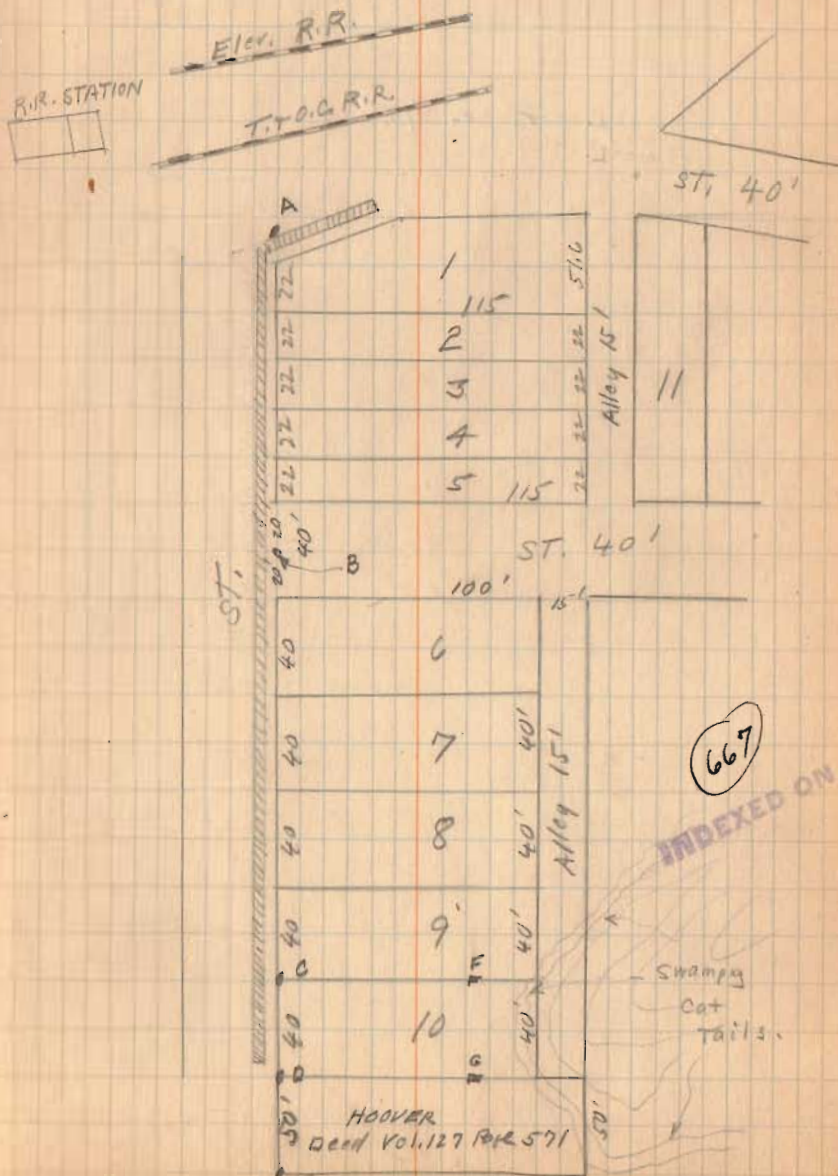

Lamb survey lot. 10

see Page 45

8-11-28

76

