


6/4/17  
 Survey of "Wedge" - Sec. 36 - T. 6 R. 8,  
 Washington Twp. for George Ginn.

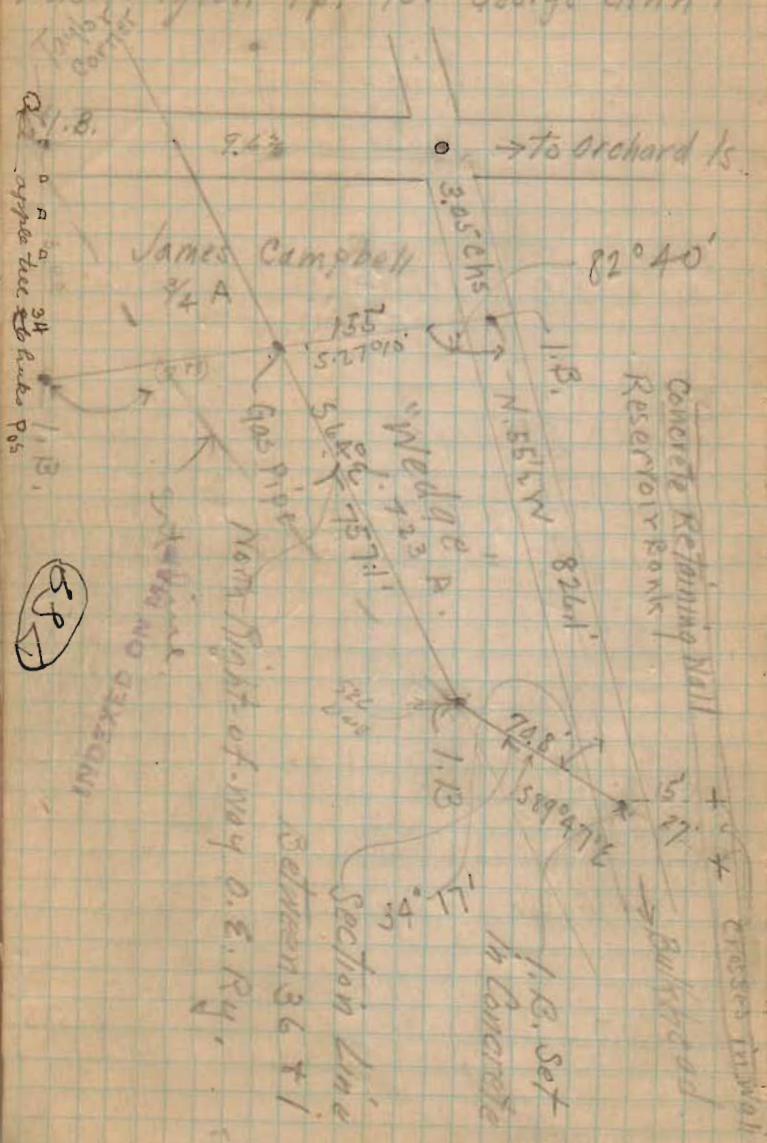

34  
 66  
 204  
 204  
 224

305  
 66  
 1830  
 1830  
 20130

762  
 66  
 5772  
 5772  
 63492