


Orchard Island Road survey

Washington Twp

Sec 36 T 6 R 8

Sec 36 T 6 R 8 East.

Scale 1" = 100'

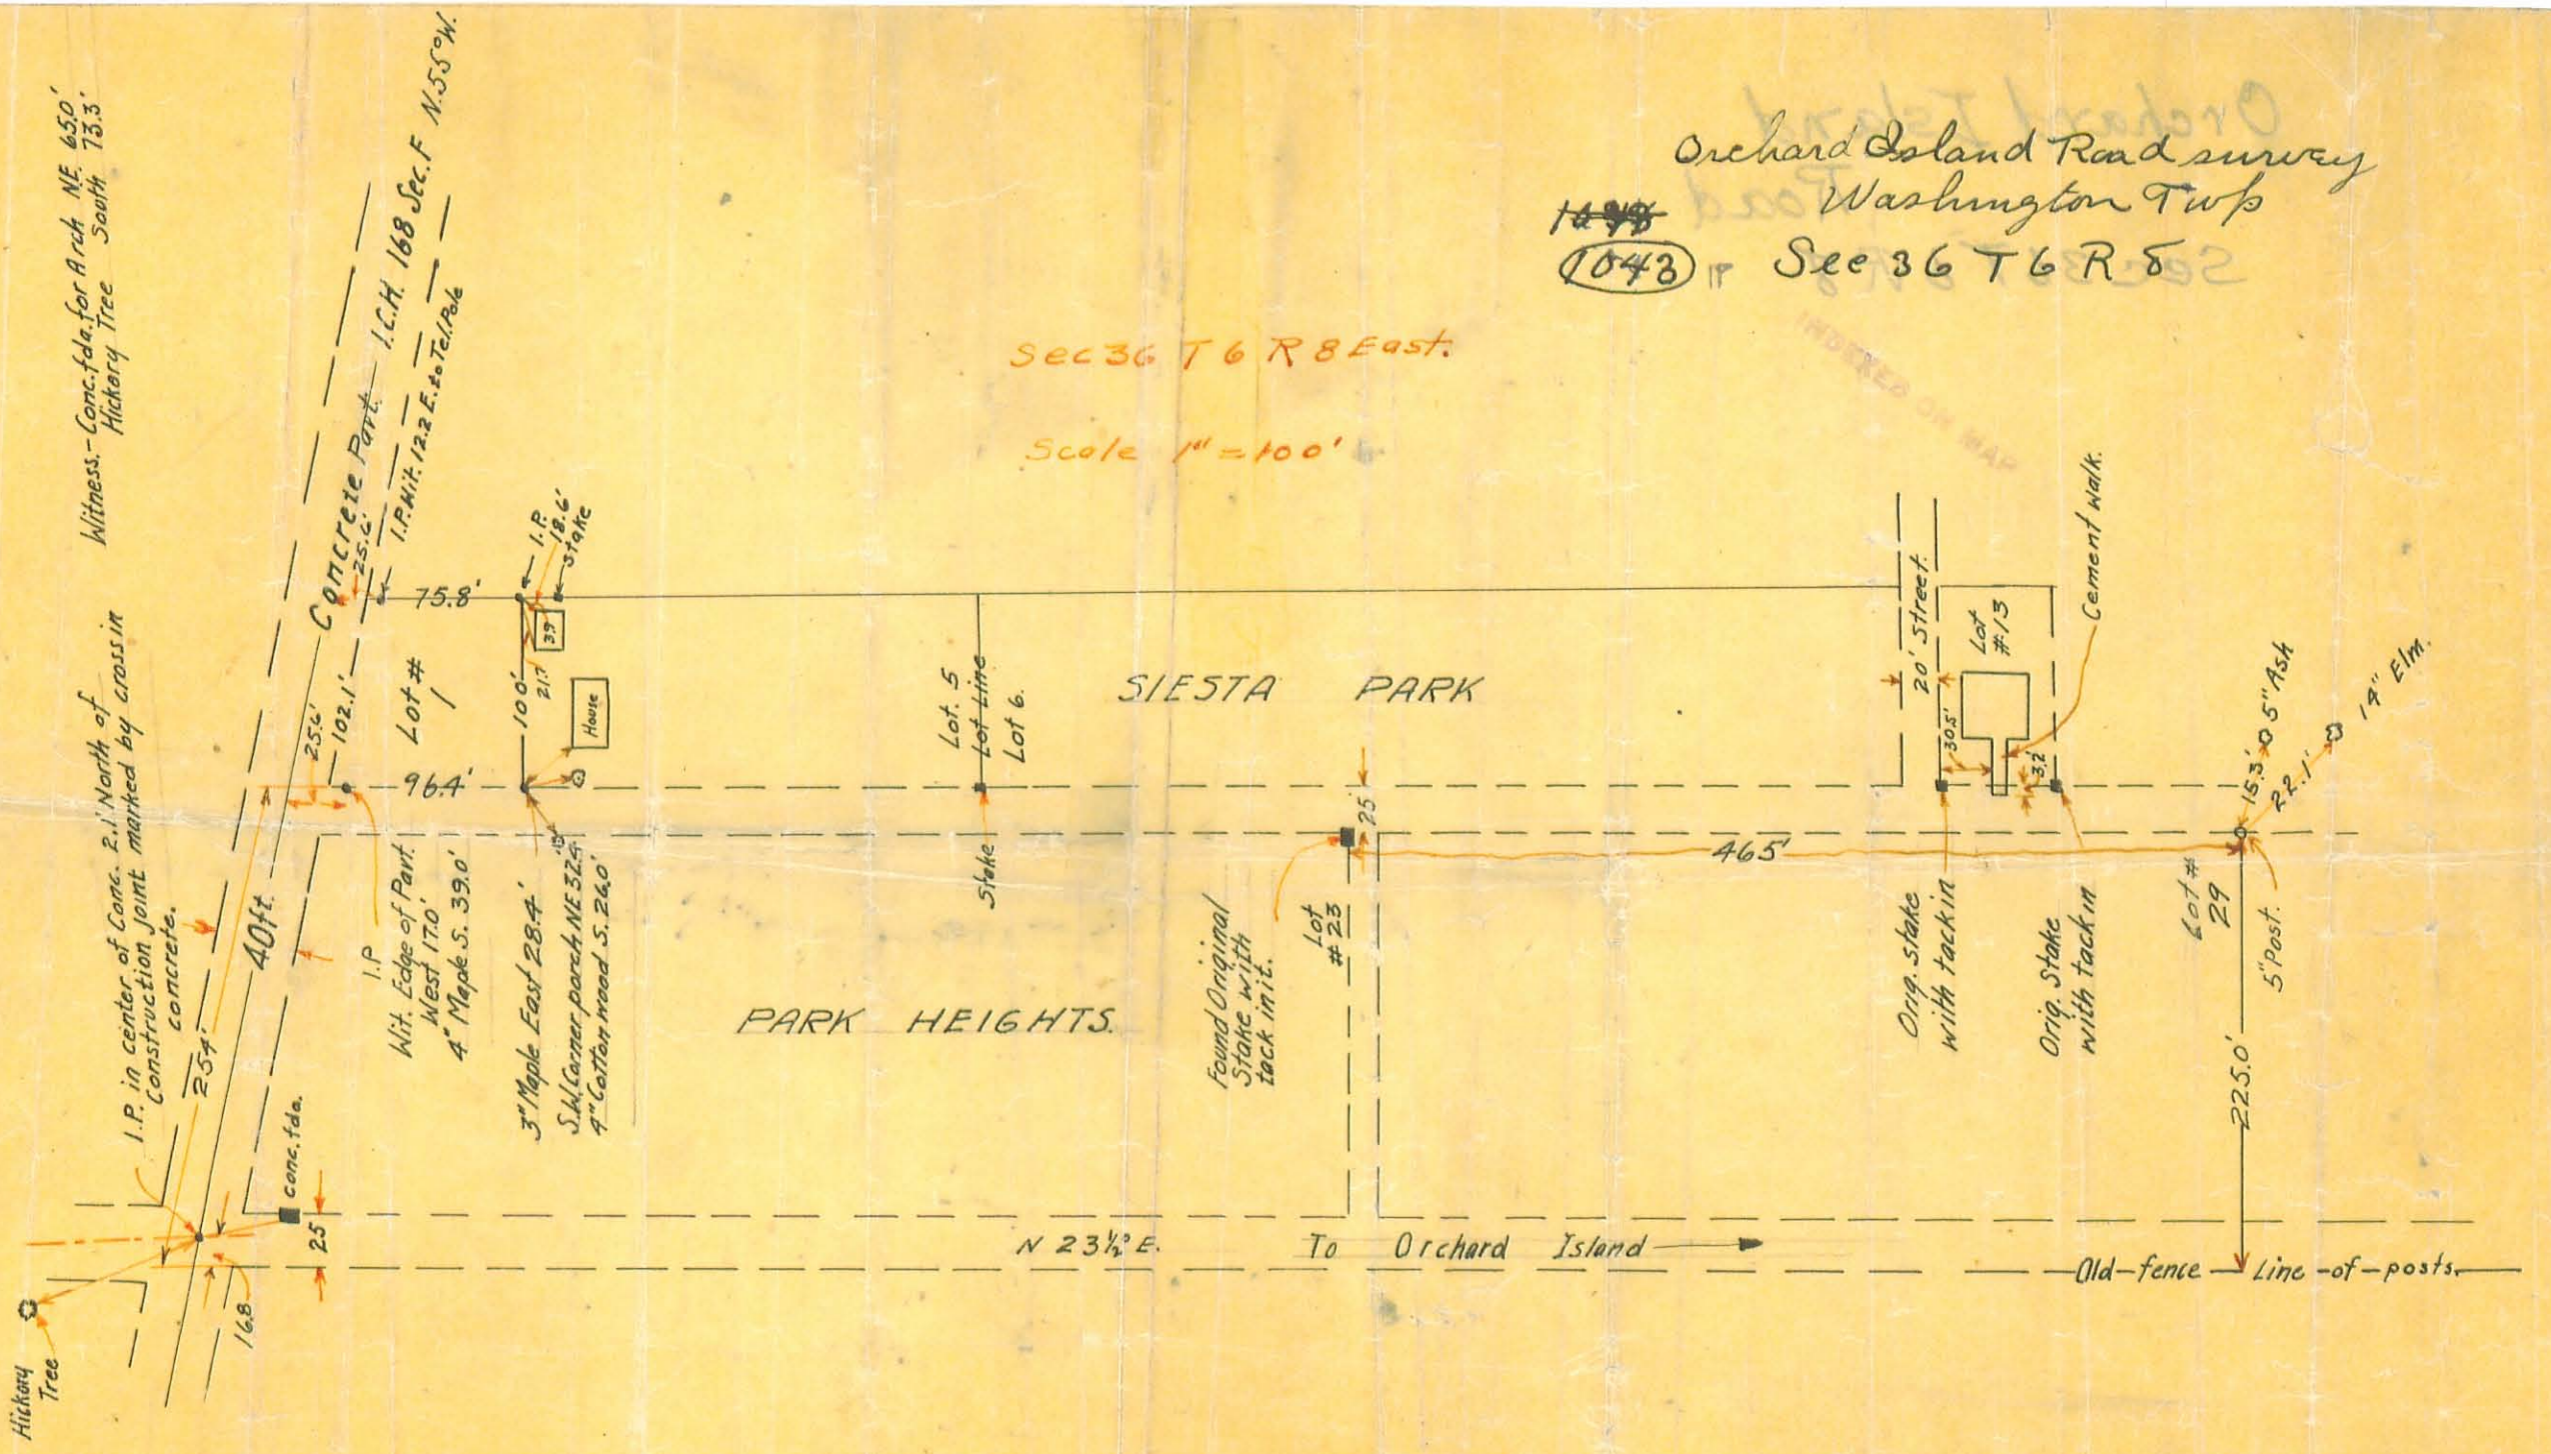

I.P. in center of Conc. 2.1' North of construction joint marked by cross in concrete.

40ft

conc. fda.

1.P. Edge of Part. West 170' 4" Maple S. 39.0'

Lot # 1

Concrete Part. I.C.H. 168 Sec. F N. 55° W. I.P. Wit. 122 E. 20' Tel. 186'

75.8'

3" Maple East 28.4' S.W. Corner porch NE 32.5' 4" Cotton road S. 24.0'

House

1.P. 18.6' Stake

Lot 5 Lot line Lot 6 Stake

SIESTA PARK

PARK HEIGHTS

Found Original Stake with tack in it.

Lot # 23

Orig. stake with tack in

Orig. Stake with tack in

Cement walk.

20' Street

Lot # 13

Lot # 29

5" Post.

15.3' x 0.5" Ash R.R. 1'

19" Elm.

Old fence Line of posts.

To Orchard Island

N 23 1/2° E