

Surrey Lots 97-99 Russells Pt.

Lots 100-101 Russells Pt

97-99 for Lester L Wilkins Lima Ohio

100-101 for Pearl ^{McK}Misat Russells Point

See SA Buchanan Field Book


County Engineer's No 442 Page 11

for original notes

- A' iron pipe (found) accepted
- B iron pipe (found) accepted
- C post (found) Distance A to B and B to C ok
- D pipe (set)
- E pipe (set)
- F iron bar (found) accepted
- G pipe (set)
- H pipe (set)
- I iron bar (set)
- J iron bar (set)
- K pipe (set)
- L pipe (set)
- M pipe (set)

CAMSLIP
CAMMILL
D. FORRY

9/5/06

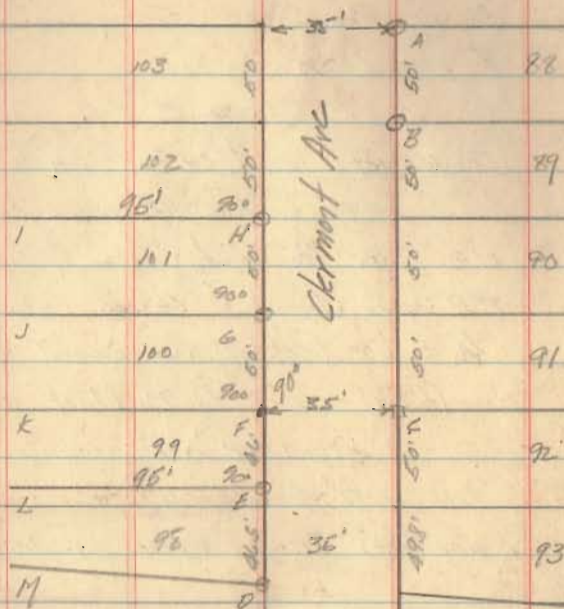

INDEXED ON MAP

2310