


Survey of Lot No 32  
 Russells Point Ohio for  
 Wm King  
 Plat Book B Vol 2 Page 53  
 Logan County Records

Lots 53-54-55  
 51-52-53

INSKEEP Hilly  
 F. B. L. Howell  
 Edith Hughes

- A pipe (found) accepted 4/10/12 at
- B pipe (found) accepted 12/10/12 at
- C pipe (found) accepted 12/10/12 at
- D Pipe (found) accepted 12/10/12 at
- E Stake (found) see book 1 page 51 at
- F Stake (found) see book 1 page 51 at
- G Stake with tag (found) see 53 3' W of 8
- H " " (found) see 53 3' W of 8
- I " " (found) see 53 3' W of 8
- J " " (found) see 53 3' W of 8
- K 1/2" pipe (found) see 53 3' W of 8

See Book 11 Page 21 for survey  
 53  
 54  
 55


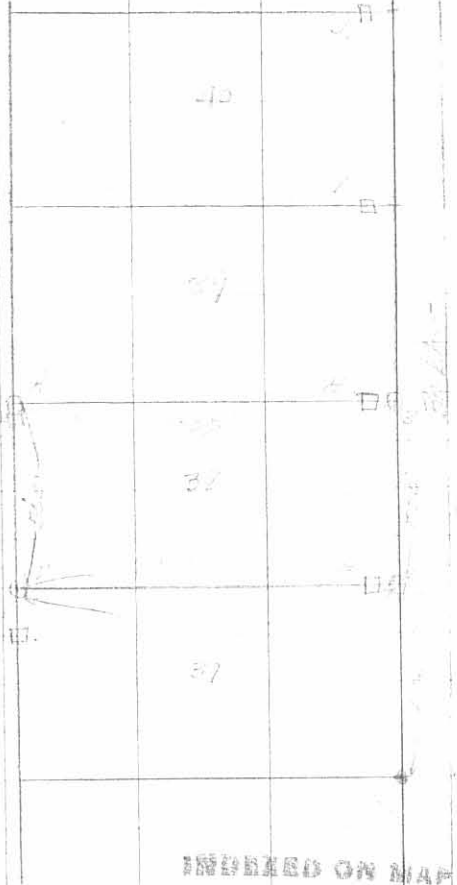


Corrected ok  
 12/10/12

INDEXED ON MAP

2345 1P

REV'D 9-29-05 GJM CLK

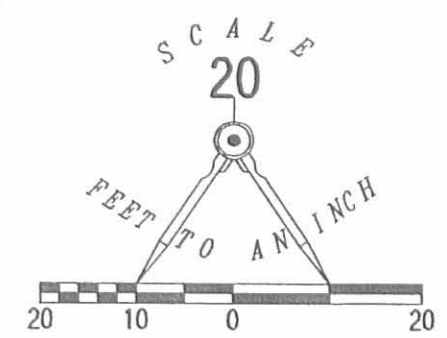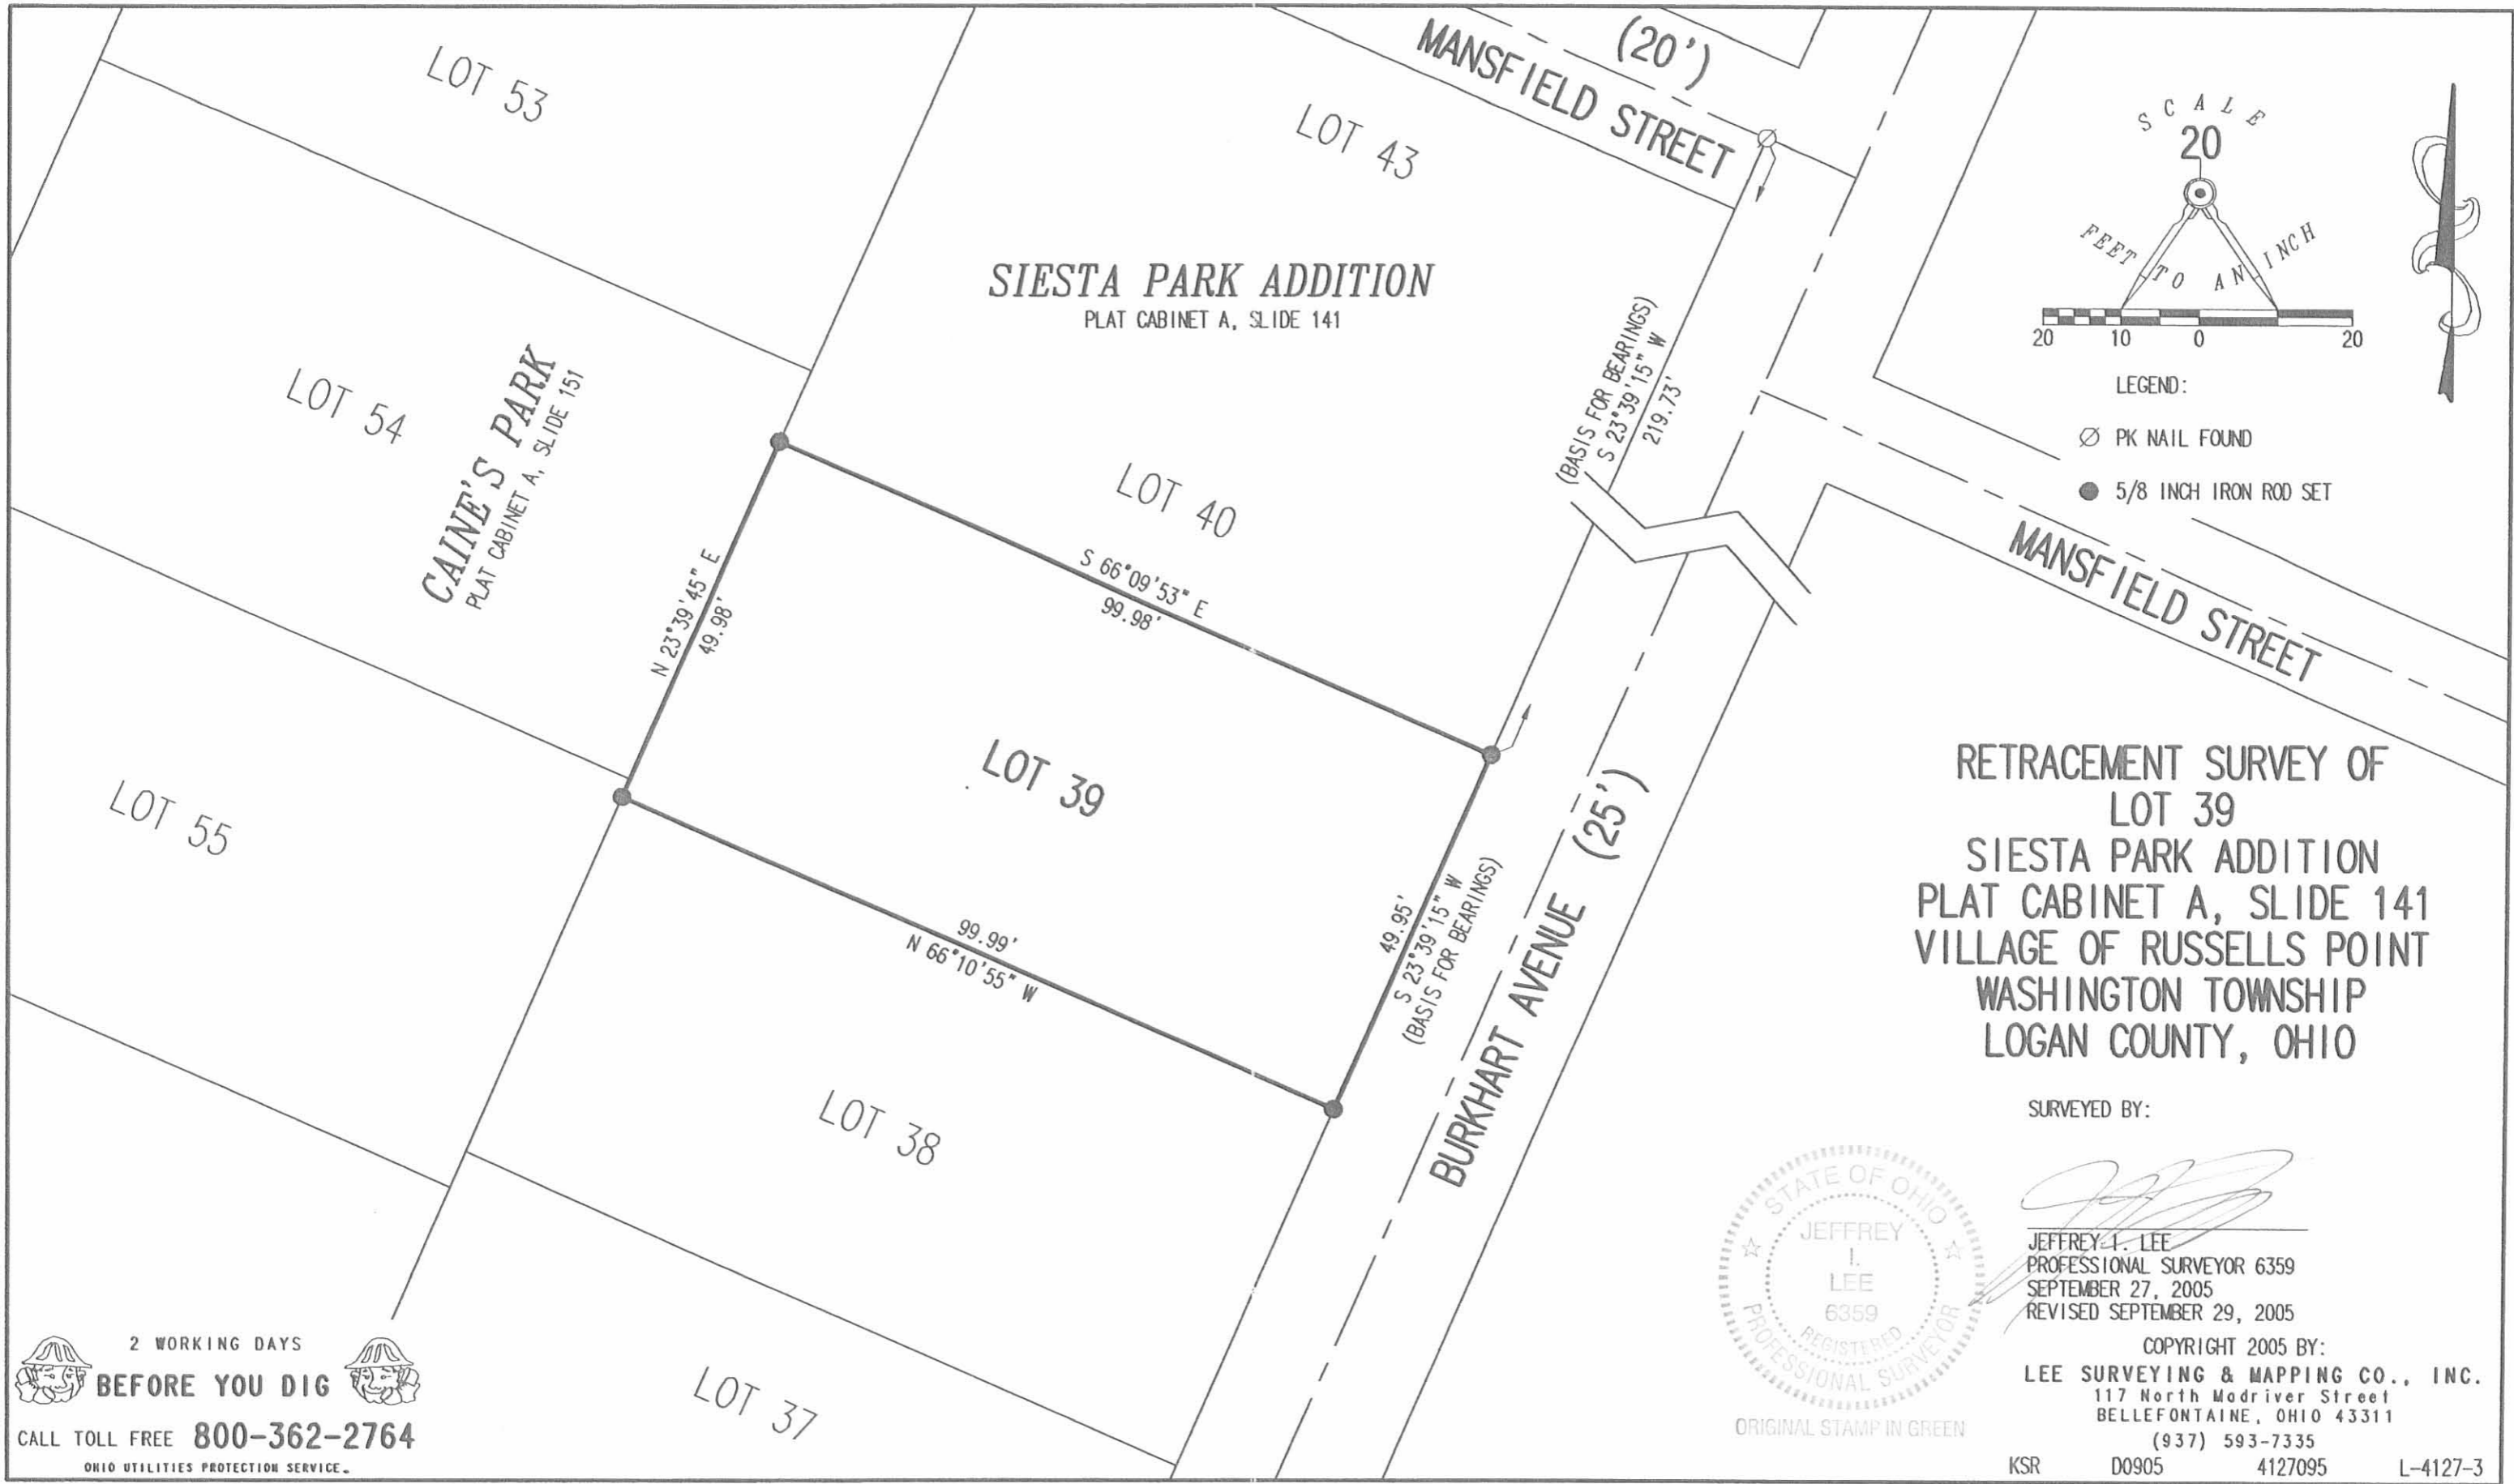

- LEGEND:
- ⊗ PK NAIL FOUND
  - 5/8 INCH IRON ROD SET

RETRACEMENT SURVEY OF  
 LOT 39  
 SIESTA PARK ADDITION  
 PLAT CABINET A, SLIDE 141  
 VILLAGE OF RUSSELLS POINT  
 WASHINGTON TOWNSHIP  
 LOGAN COUNTY, OHIO

SURVEYED BY:

*[Signature]*  
 JEFFREY I. LEE  
 PROFESSIONAL SURVEYOR 6359  
 SEPTEMBER 27, 2005  
 REVISED SEPTEMBER 29, 2005



ORIGINAL STAMP IN GREEN

COPYRIGHT 2005 BY:  
 LEE SURVEYING & MAPPING CO., INC.  
 117 North Madriver Street  
 BELLEFONTAINE, OHIO 43311  
 (937) 593-7335  
 KSR D0905 4127095 L-4127-3

2 WORKING DAYS  
**BEFORE YOU DIG**  
 CALL TOLL FREE **800-362-2764**  
 OHIO UTILITIES PROTECTION SERVICE


2345 2P

Survey of Lot No 38  
Russells Point Ohio for  
Win Kingrey  
Plat Book B Vol 2 Page 43  
Logan County Records

- A pipe (found) accepted NW cor Lot 38  
 B pipe (found) accepted NE cor Lot 38  
 C pipe (found) accepted SE cor Lot 38  
 D Pipe (found) accepted SW cor Lot 38  
 E stake (found) see book 11 Page 31 <sup>SW cor</sup> Lot 55  
 F stake (found) see book 11 Page 31 <sup>NW cor</sup> Lot 55  
 G stake with tack (found) on line DC 3' W of C  
 H stake with tack (found) on line AB 3' W of B  
 I " " " (found) on line GH 50' N of G  
 J " " " (found) on line GI 50' N of I  
 K iron bolt (found) 50' S of G on line BC  
 accepted for SE cor Lot 37

Occupation ok  
No encroachments.

Allyscoop 4/11/17  
Fritz L Howell  
Robt. Hughes

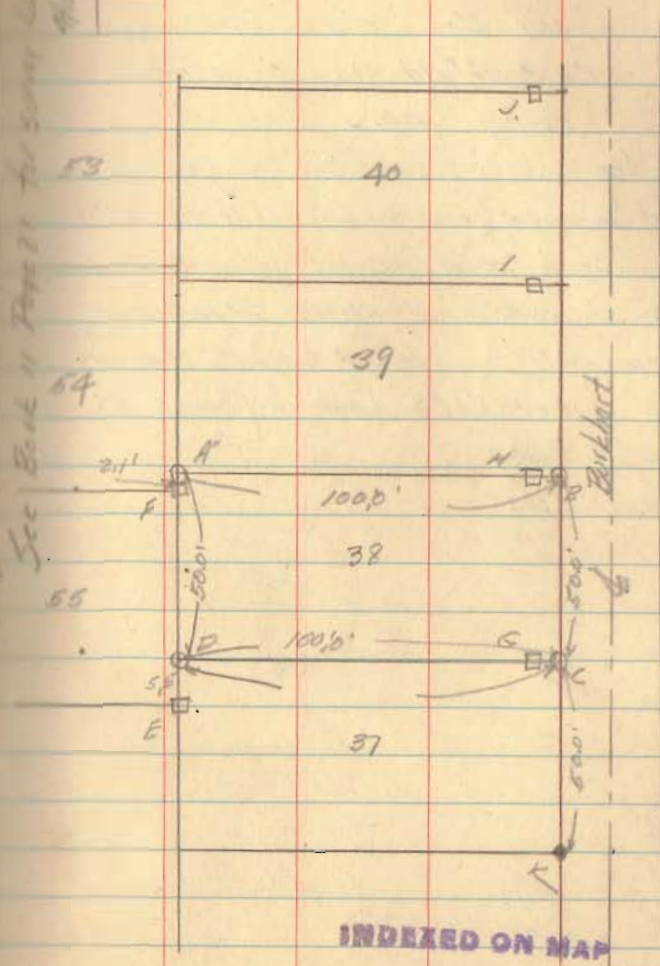

2345